





SOUTH ELEVATION

SCALE: 1/4" = 1'-0"

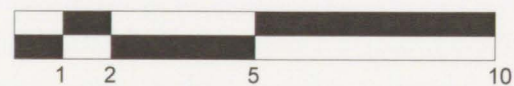

Material Finish Key

- ① Hardiboard concrete siding. Stained and sealed.
- ② Marine grade plywood horizontal siding.
- ③ FasWall recycled composite masonry. Sanded and sealed.
- ④ Galvalume standing seam metal roofing and siding.
- ⑤ Recycled decking. Color and manufacturer TBD.
- ⑥ PSPV BOX.
- ⑦ Flat steel flashing.
- ⑧ Translucent window area: Polygal filled with Aerogel.
- ⑨ Passive ventilation provided per NREL recommendations.

 University of Colorado - Denver/Boulder College of Architecture and Planning, College of Engineering and Applied Science, and Leeds School of Business University of Colorado at Boulder • 422 UCB • Boulder, CO 80309 Phone: 303-492-2536 • Fax: 303-492-6163, ATTN: Solar-D		
 2005 National Solar Decathlon - Washington, DC		
Title: SOUTH ELEVATION		
Revisions (Name/Date): K FIELD 07/31/05		Date: 6/9/05 Drawn by: CRUZ Checked By:
		Drawing A3.1 Sheet 8 of 22