
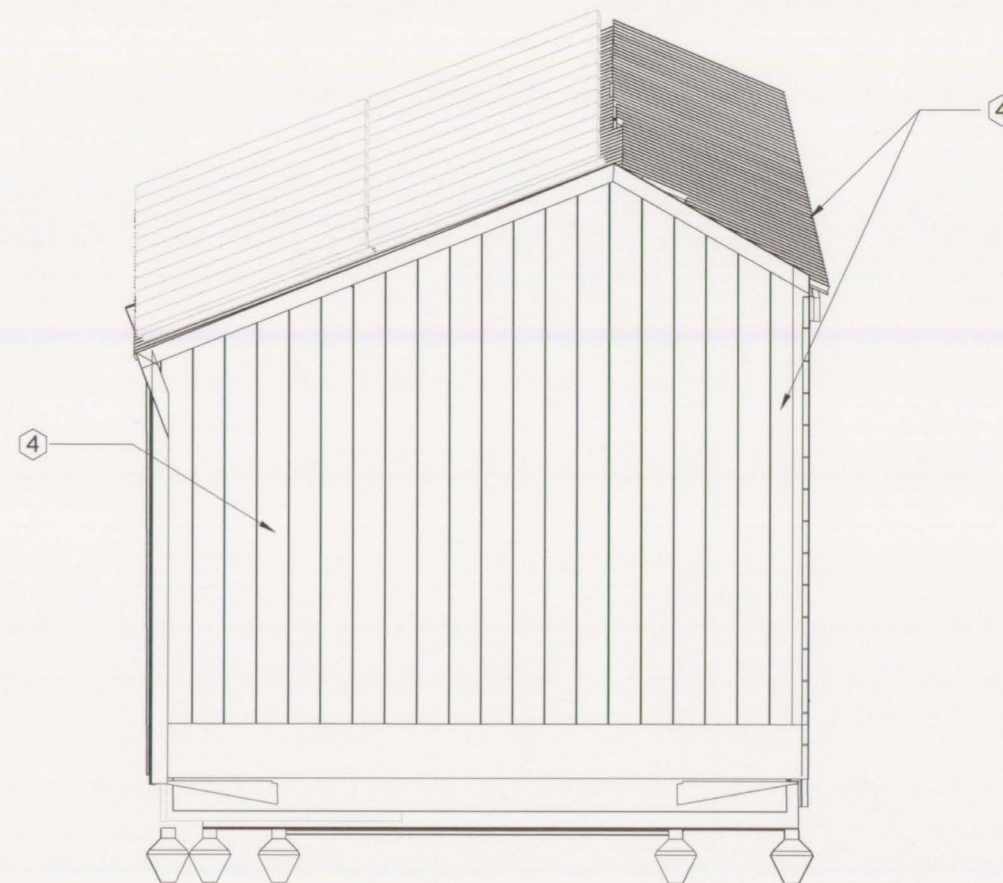


WEST ELEVATION

SCALE: 1/4" = 1'-0"

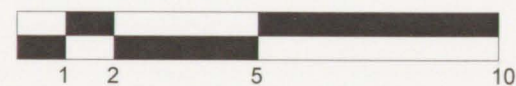

EAST ELEVATION

SCALE: 1/4" = 1'-0"

Material Finish Key

- ① Hardiboard concrete siding. Stained and sealed.
- ② Marine grade plywood horizontal siding.
- ③ FasWall recycled composite masonry. Sanded and sealed.
- ④ Galvalume standing seam metal roofing and siding.
- ⑤ Recycled decking. Color and manufacturer TBD.
- ⑥ PSPV BOX.
- ⑦ Flat steel flashing.
- ⑧ Translucent window area: Polygal filled with Aerogel.
- ⑨ Passive ventilation provided per NREL recommendations.



**University of Colorado -
Denver/Boulder**

College of Architecture and Planning,
College of Engineering and Applied Science, and
Leeds School of Business

University of Colorado at Boulder • 422 UCB • Boulder, CO 80309
Phone: 303-492-2536 • Fax: 303-492-6163, ATTN: Solar-D



2005 National Solar Decathlon - Washington, DC

Title: EAST/WEST ELEVATIONS

Revisions (Name/Date):		Date:
K FIELD	07/31/05	6/9/05
		Drawn by: CRUZ
		Checked By:



Drawing

A3.3

Sheet 10 of 22