
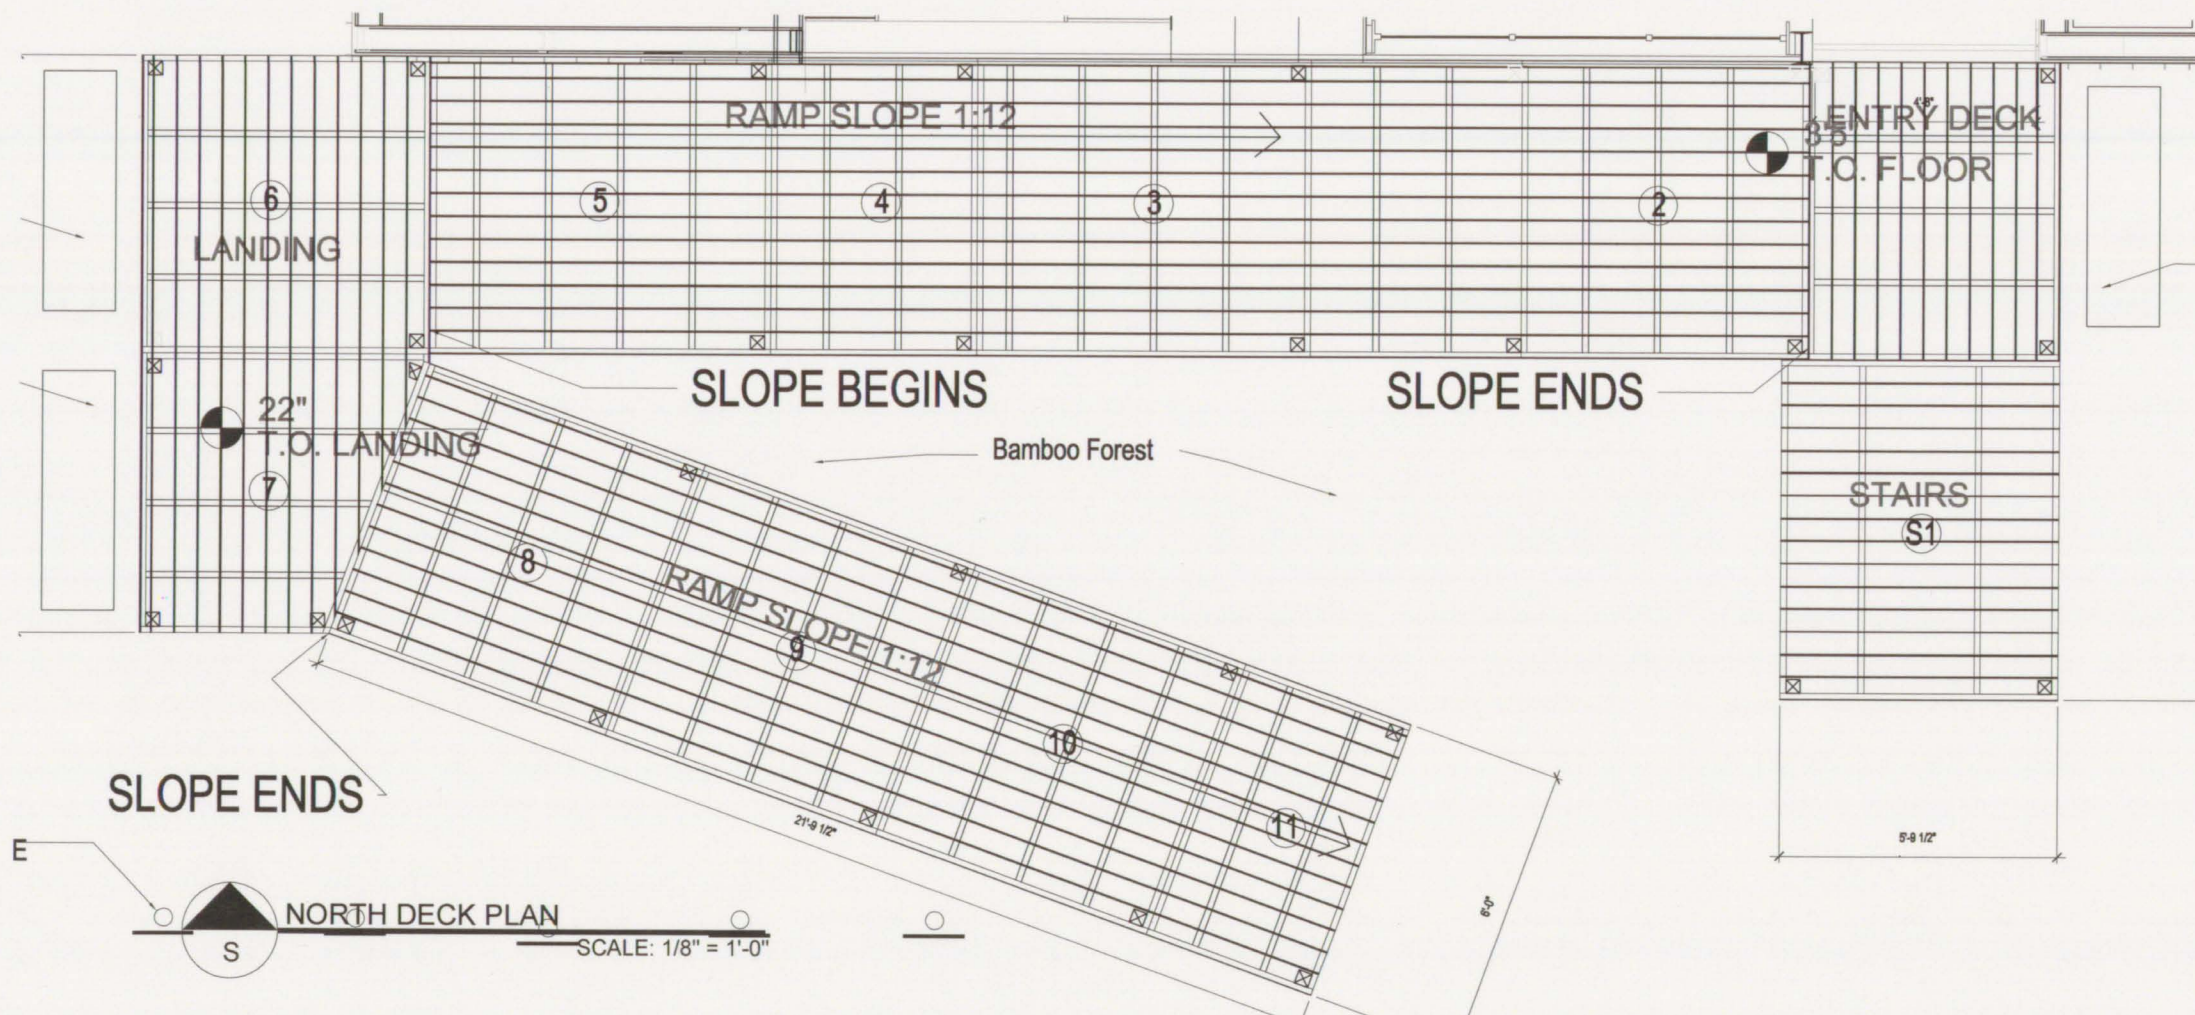
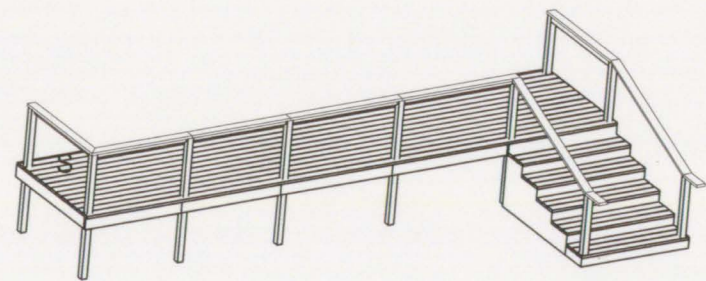


NORTH DECK PLAN
SCALE: 1/8" = 1'-0"

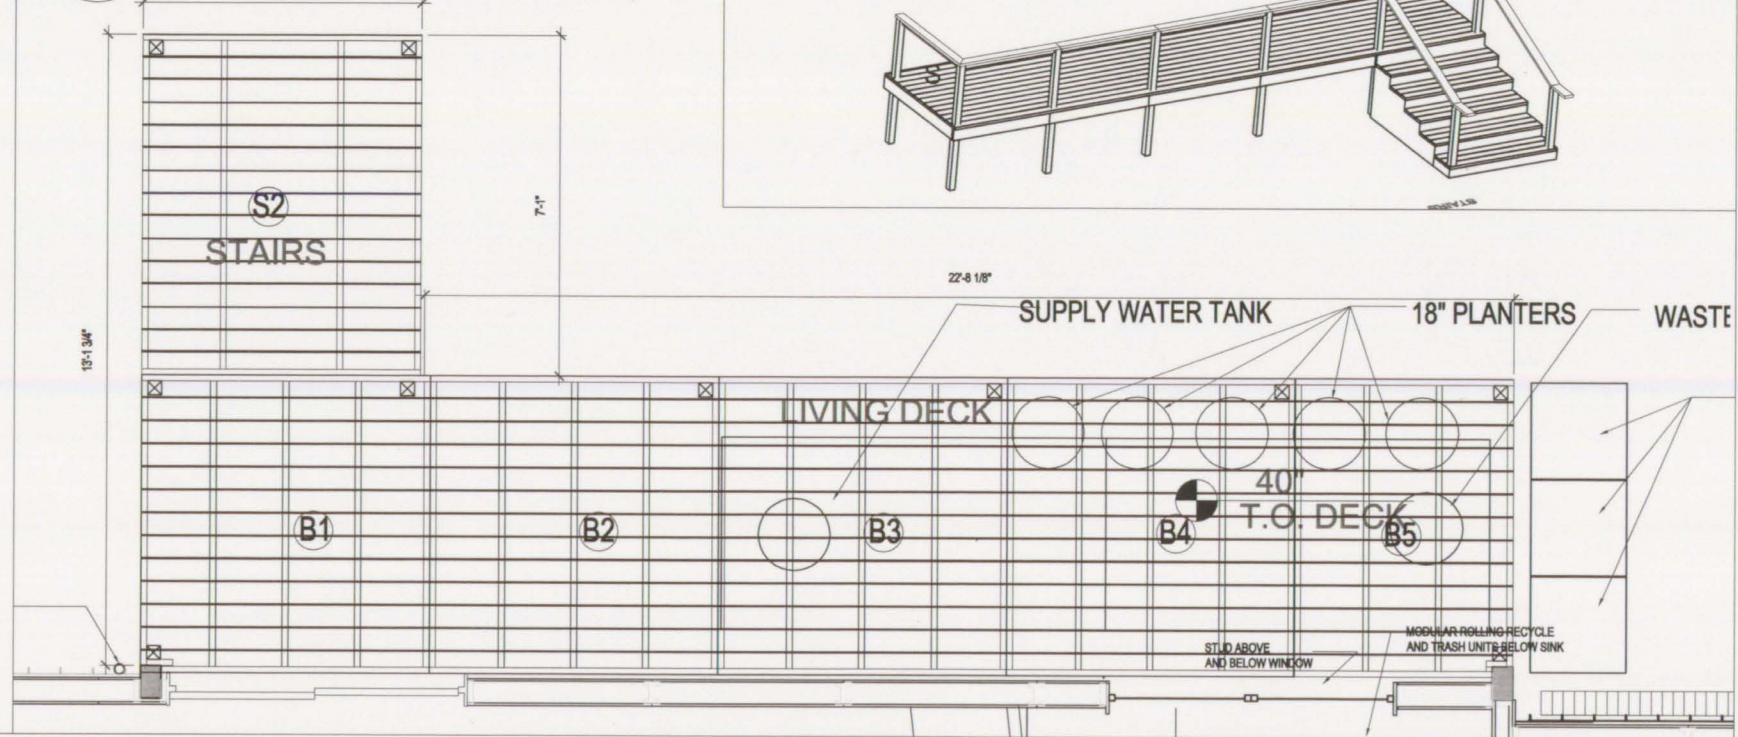

NORTH DECK PLAN
SCALE: 1/8" = 1'-0"

University of Colorado - Denver/Boulder
College of Architecture and Planning,
College of Engineering and Applied Science, and
Leeds School of Business

University of Colorado at Boulder • 422 UCB • Boulder, CO 80309
Phone: 303-492-2536 • Fax: 303-492-6163, ATTN: Solar-D

2005 National Solar Decathlon - Washington, DC

Title: DECK PLANS

Revisions (Name/Date):		Date:
K FIELD	07/31/05	6/9/05
Drawn by: MC		
Checked By: JH		

A5.1

Sheet 17 of 22