





50105

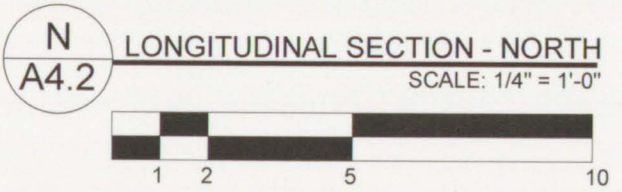

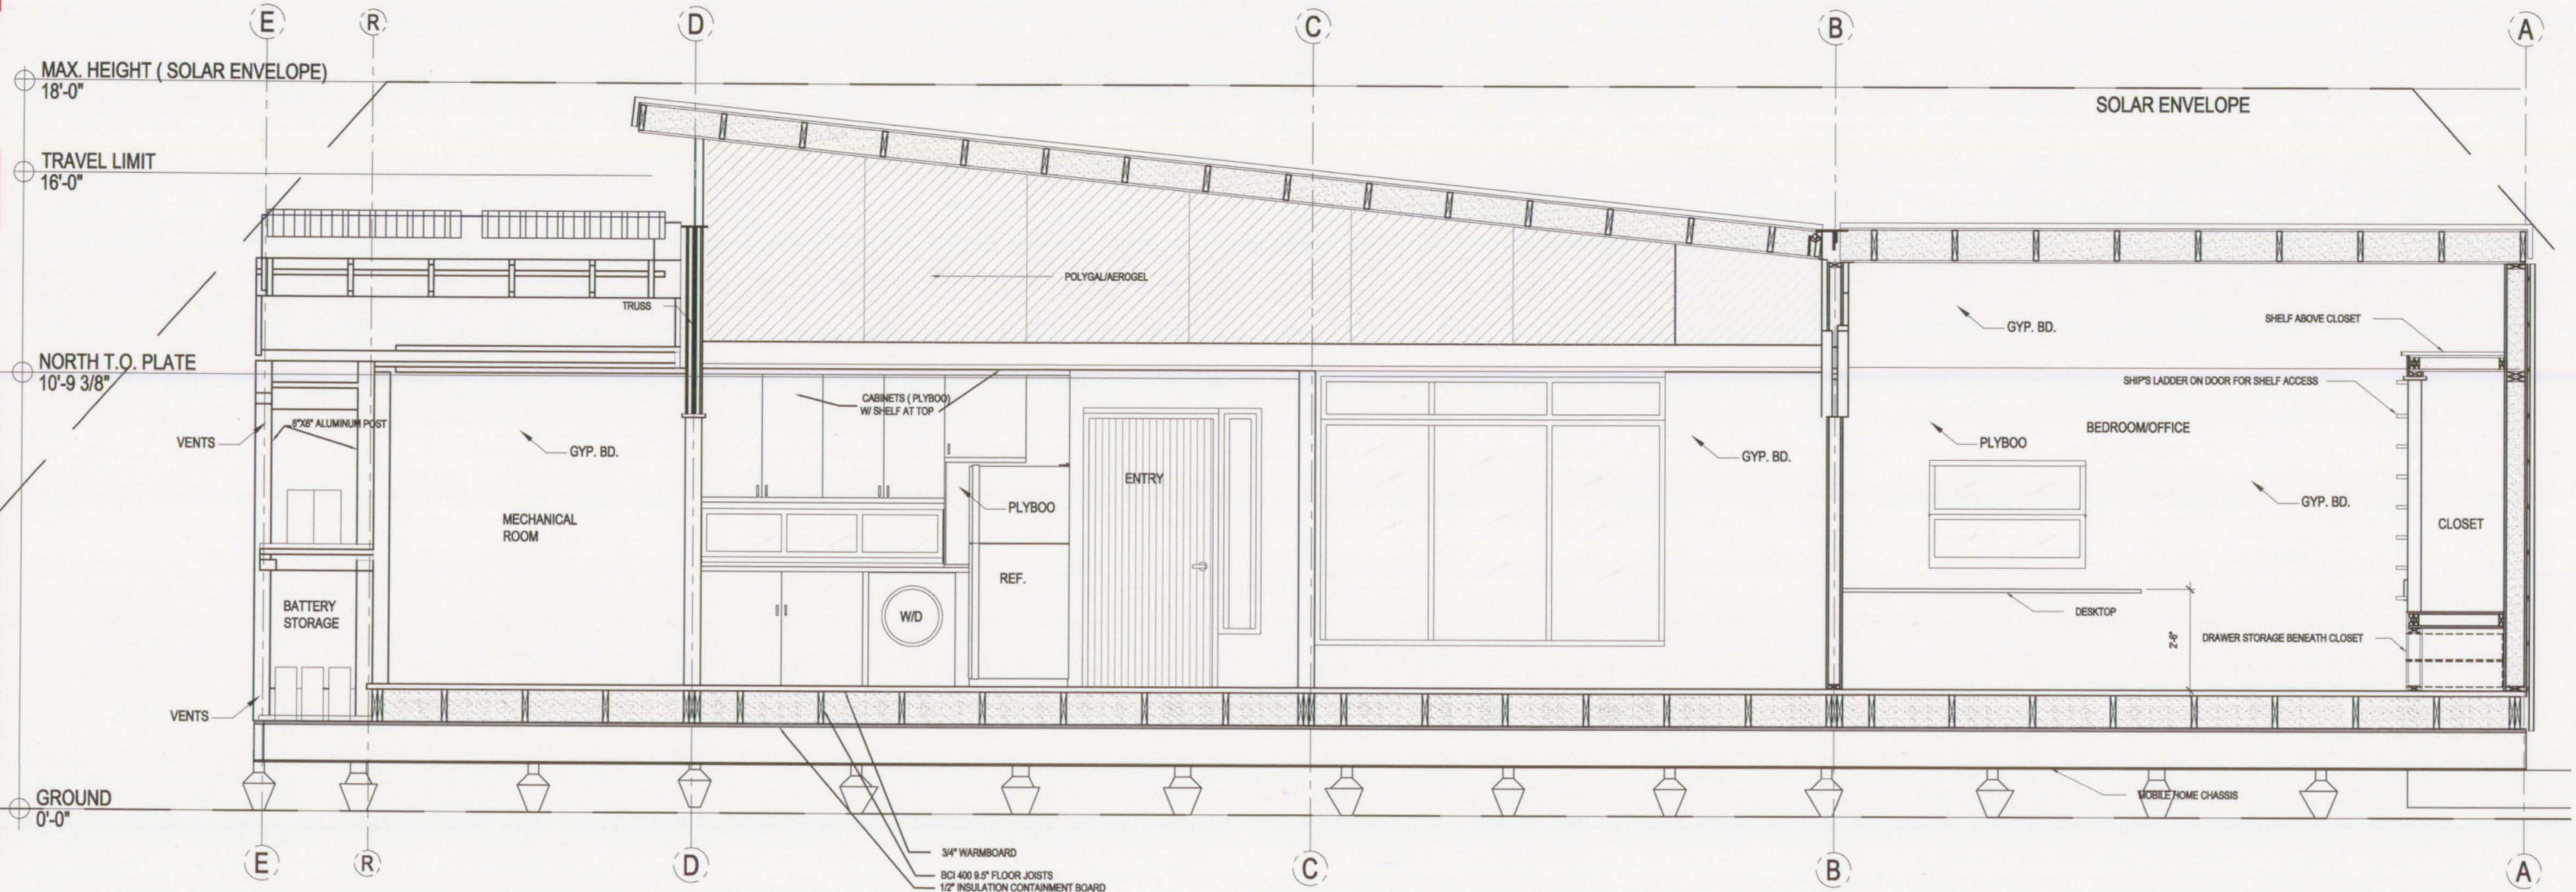

University of Colorado - Denver/Boulder
College of Architecture and Planning,
College of Engineering and Applied Science, and
Leeds School of Business
University of Colorado at Boulder • 422 UCB • Boulder, CO 80309
Phone: 303-492-2536 • Fax: 303-492-6163, ATTN: Solar-D



2005 National Solar Decathlon - Washington, DC

Drawing

A4.2

Sheet 2 of 12

Title: LONGITUDINAL SECTION NORTH VIEW

Revisions (Name/Date):		Date:
K FIELD	07/31/05	6/9/05
CRUZ	8/15/05	

Drawn by:	MC
Checked By:	JH