



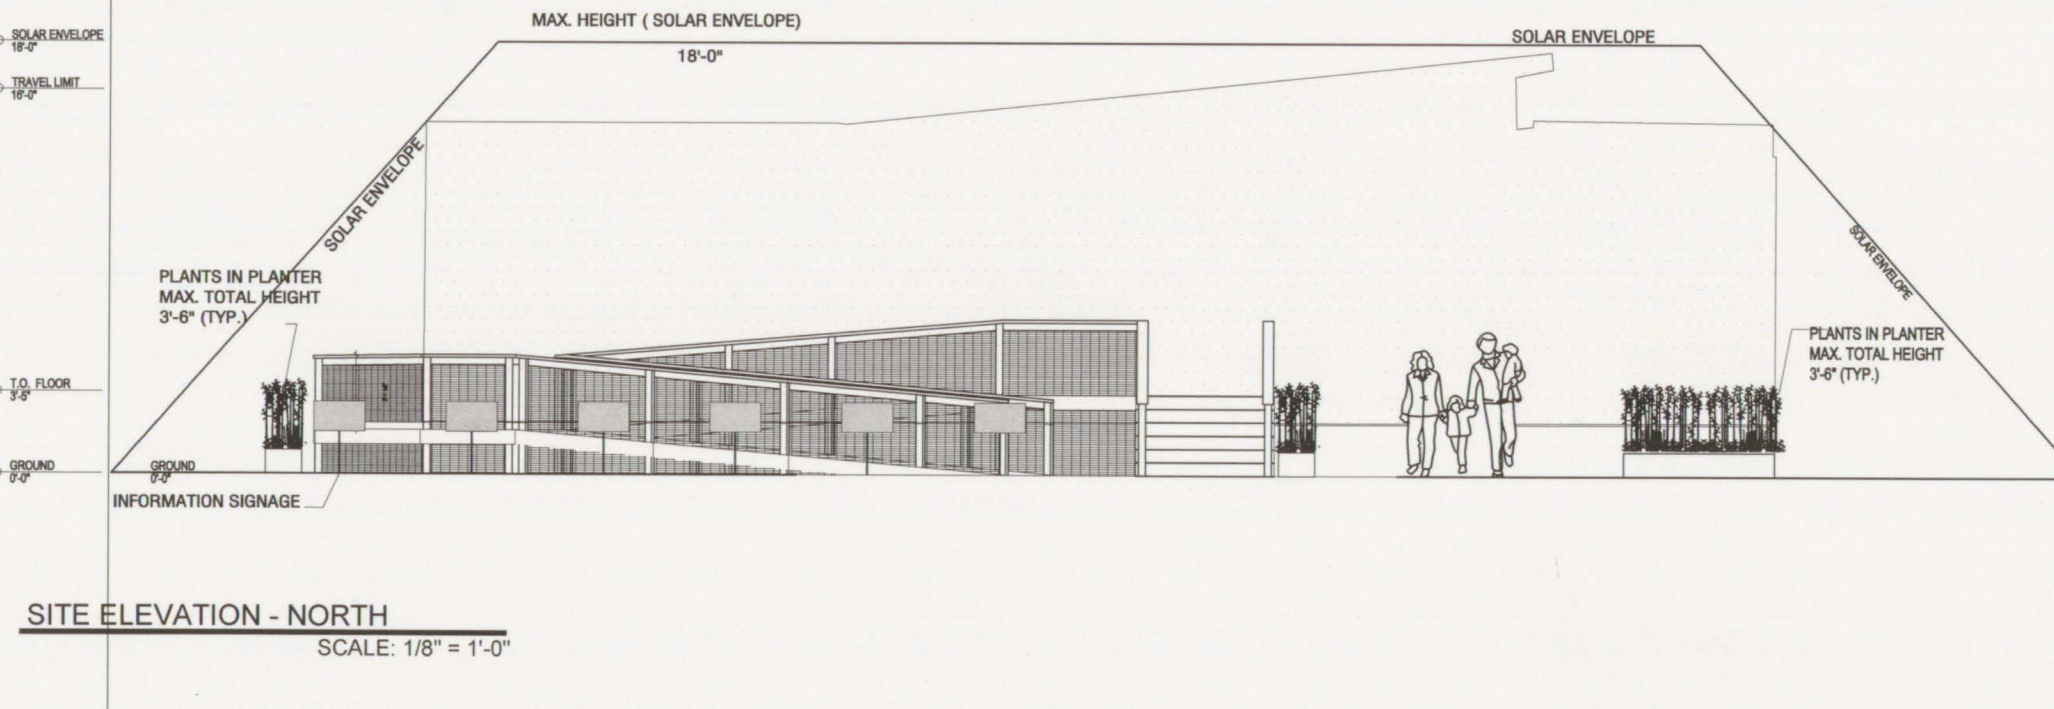


SITE ELEVATION - SOUTH
SCALE: 1/8" = 1'-0"

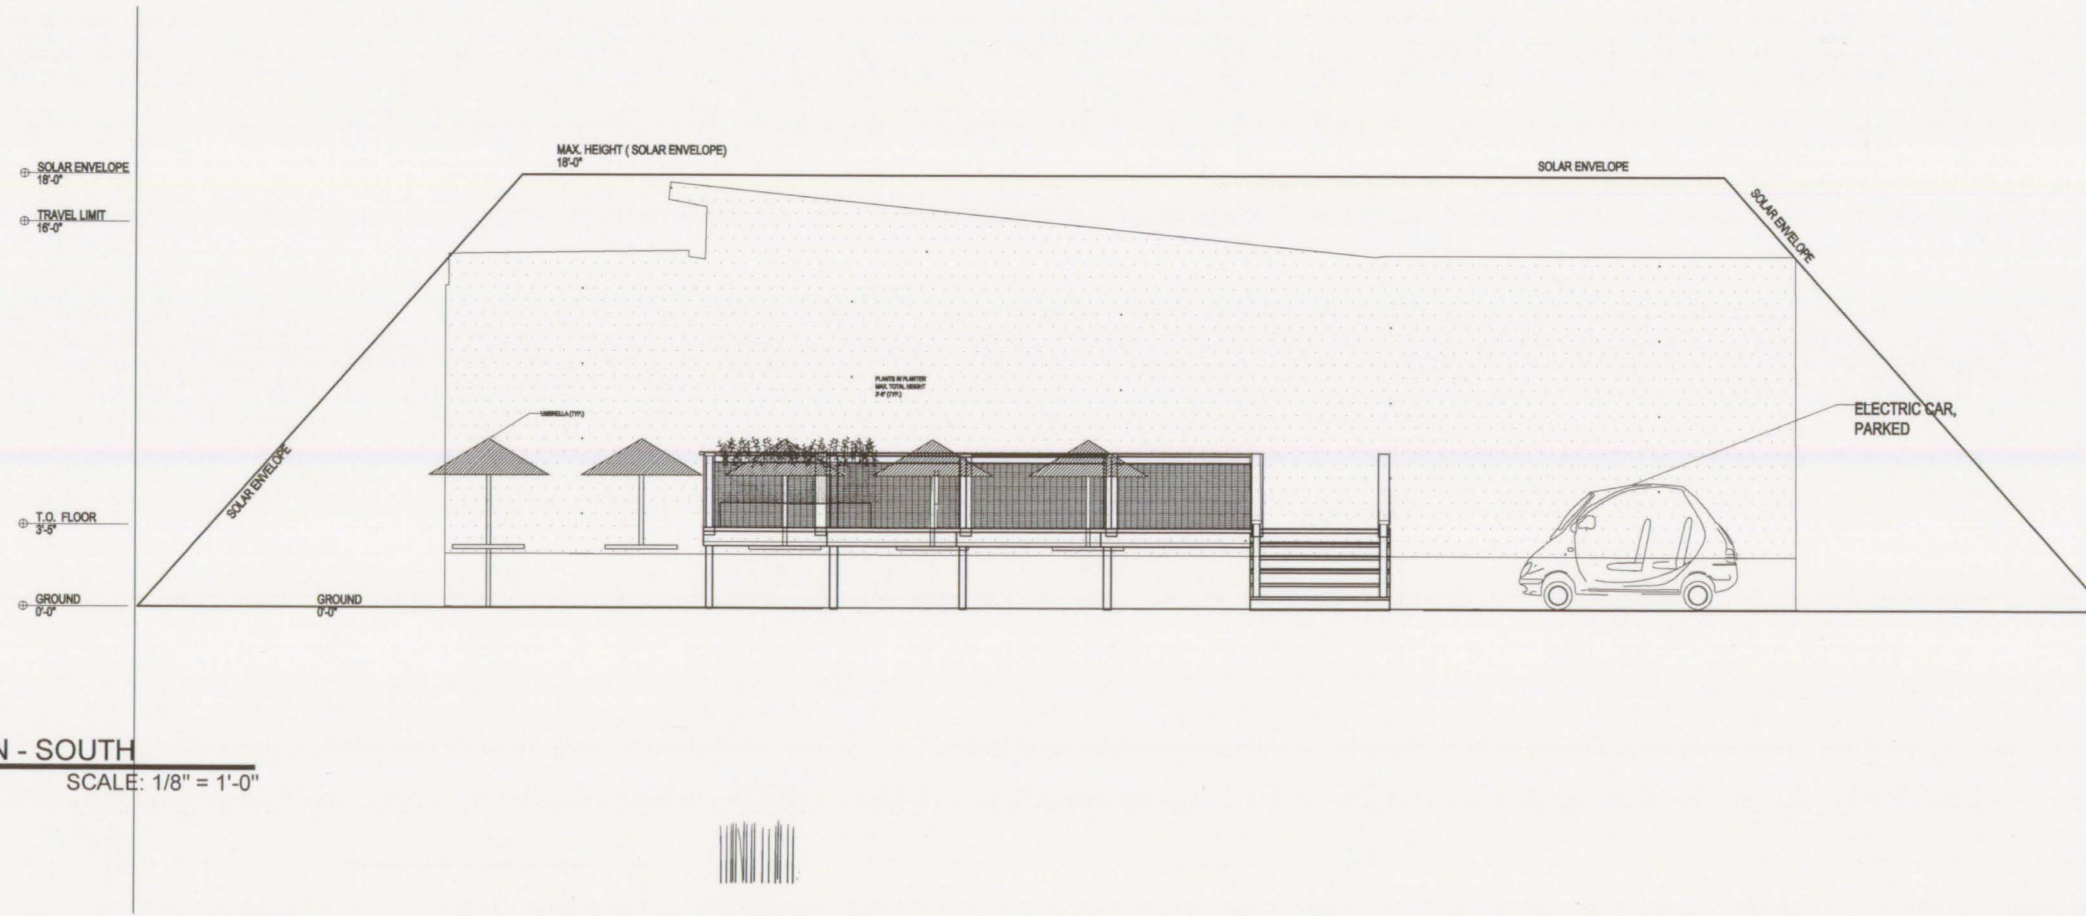

SITE ELEVATION - NORTH
SCALE: 1/8" = 1'-0"

 University of Colorado - Denver/Boulder College of Architecture and Planning, College of Engineering and Applied Science, and Leeds School of Business University of Colorado at Boulder • 422 UCB • Boulder, CO 80309 Phone: 303-492-2536 • Fax: 303-492-6163, ATTN: Solar-D		
 2005 National Solar Decathlon - Washington, DC		
Title: SITE ELEVATIONS		
Revisions (Name/Date): K FIELD 07/31/05		Date: 6/9/05
		Drawn by: MC Checked By: JH
		Drawing A1.2 Sheet 2 of 22