




50
ADA
50



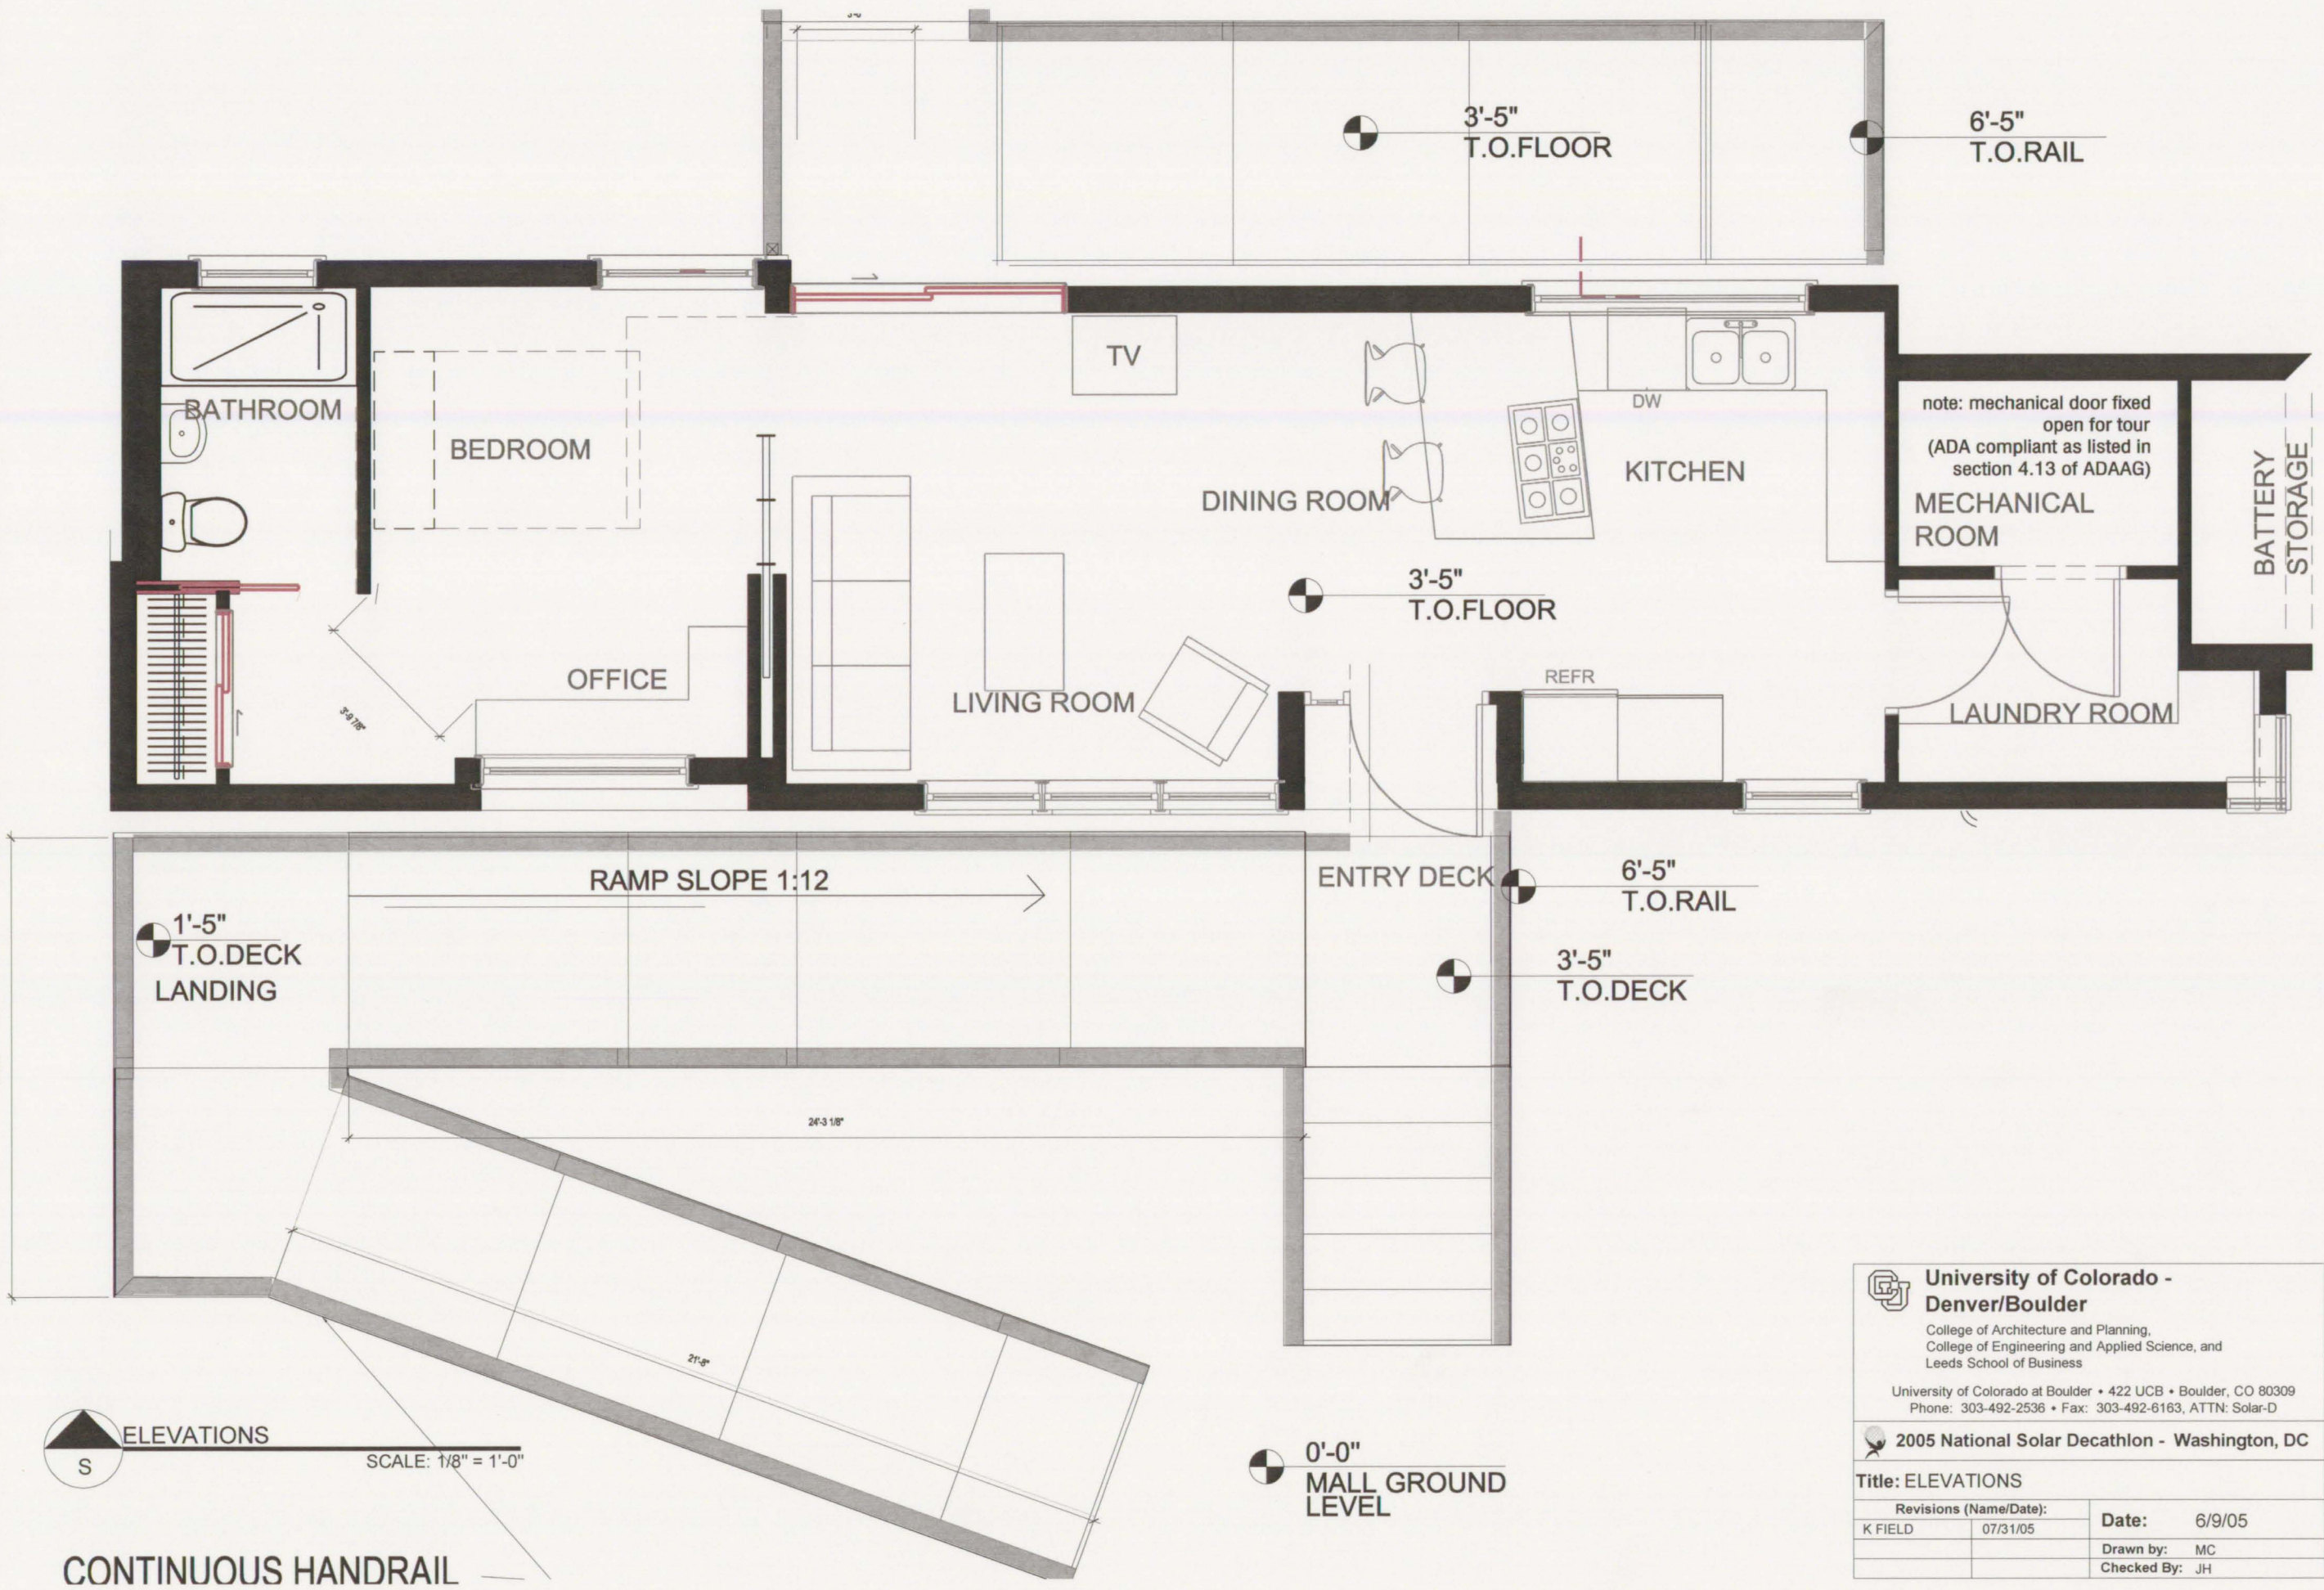

University of Colorado - Denver/Boulder
College of Architecture and Planning,
College of Engineering and Applied Science, and
Leeds School of Business
University of Colorado at Boulder • 422 UCB • Boulder, CO 80309
Phone: 303-492-2536 • Fax: 303-492-6163, ATTN: Solar-D



2005 National Solar Decathlon - Washington, DC

Title: ELEVATIONS

Revisions (Name/Date):		Date:
K FIELD	07/31/05	6/9/05
Drawn by: MC		
Checked By: JH		

Drawing

ADA2

Sheet 3 of 6