




50

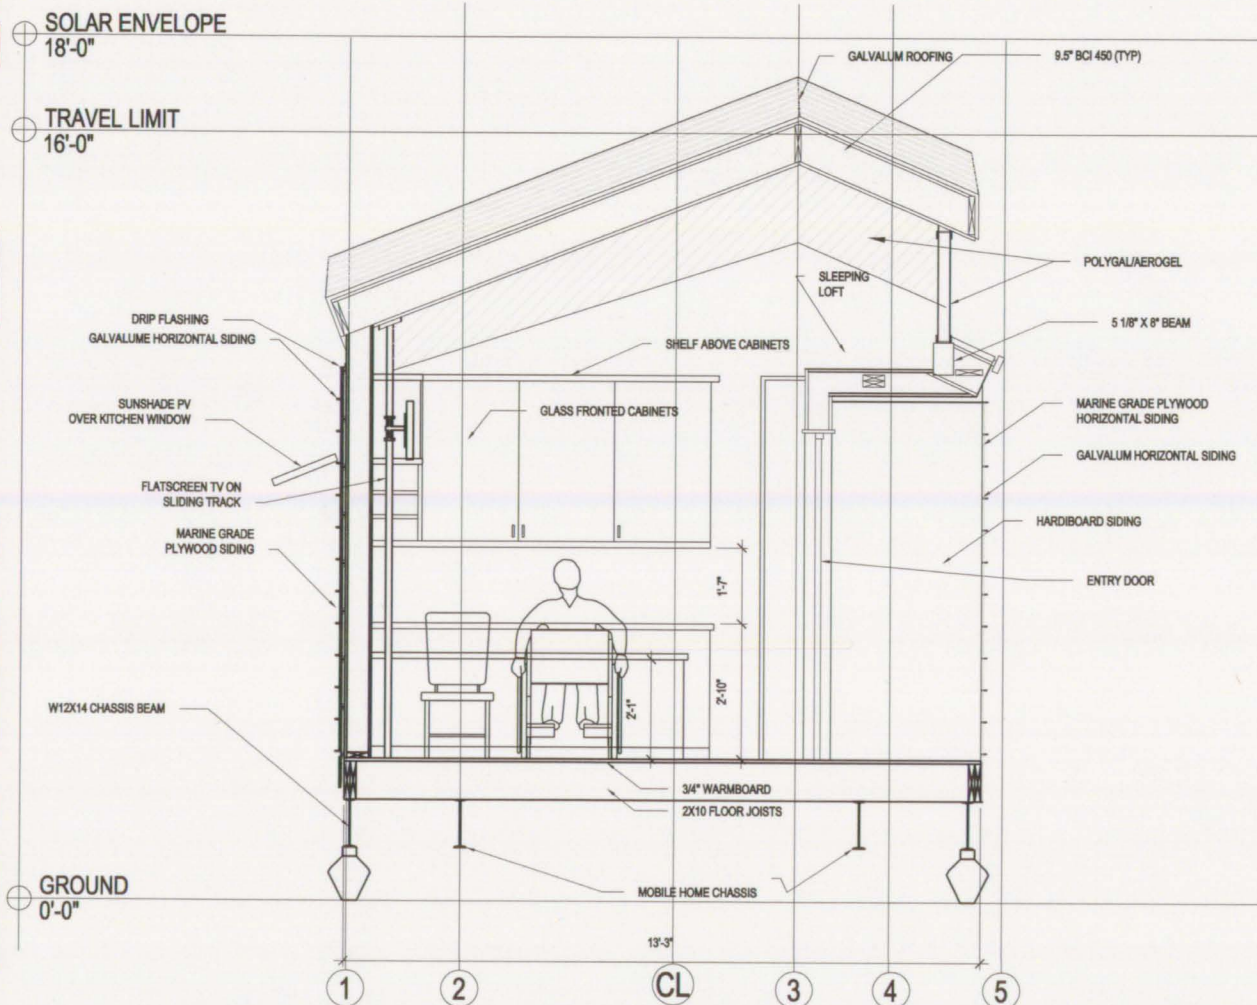


B
A4.3 ENTRY/KITCHEN SECTION
SCALE: 1/4" = 1'-0"

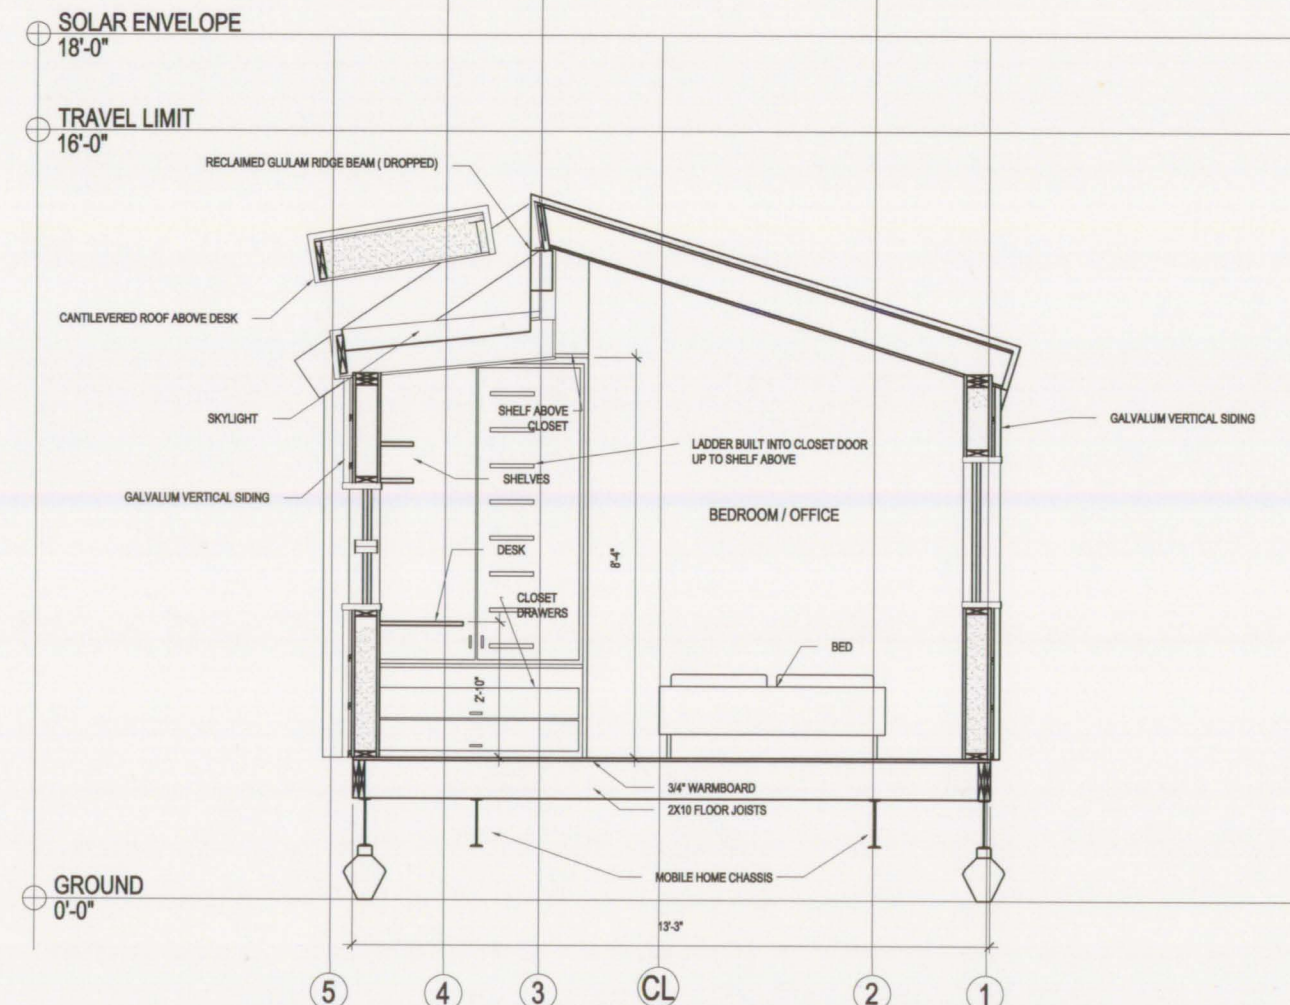


A
A4.3 OFFICE/BEDROOM SECTION
SCALE: 1/4" = 1'-0"

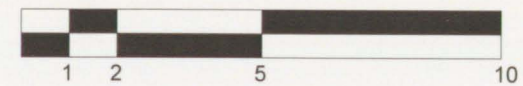


C
A4.3 MECHANICAL ROOM SECTION
SCALE: 1/4" = 1'-0"

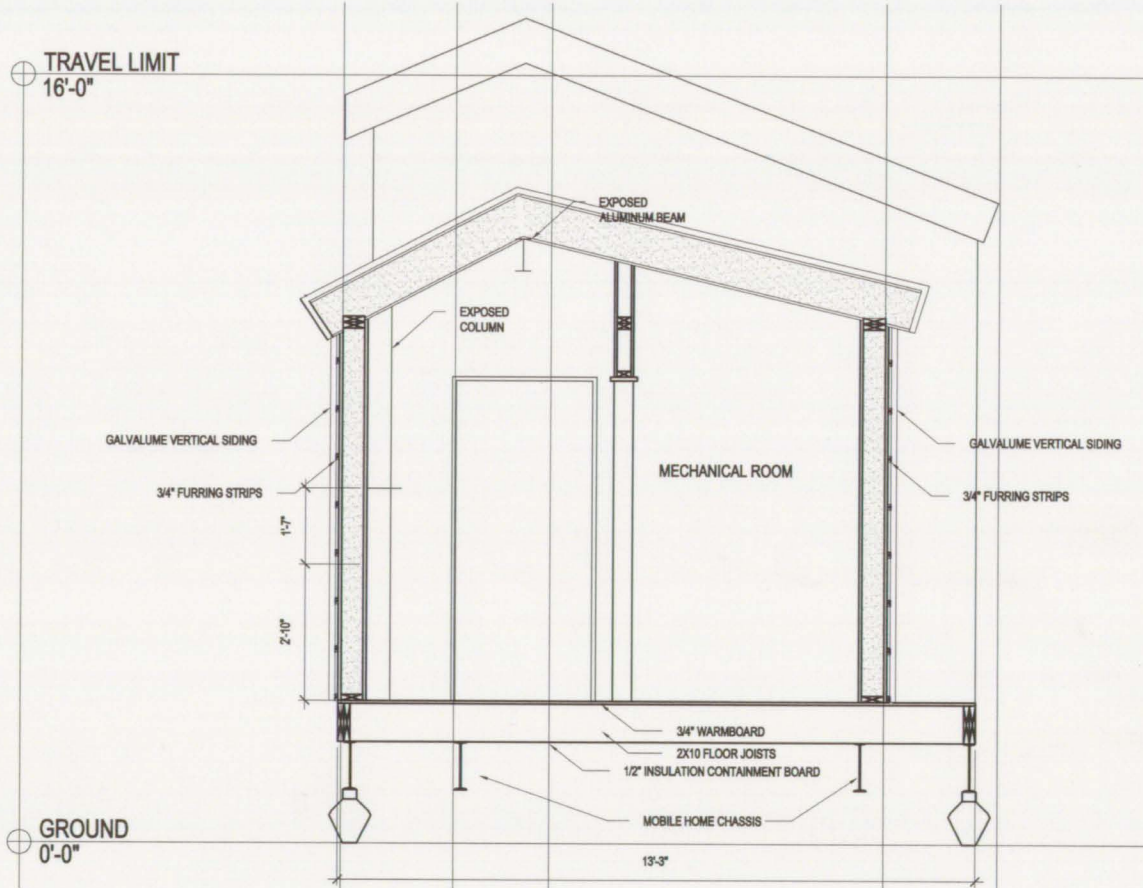



University of Colorado - Denver/Boulder
College of Architecture and Planning,
College of Engineering and Applied Science, and
Leeds School of Business

University of Colorado at Boulder • 422 UCB • Boulder, CO 80309
Phone: 303-492-2536 • Fax: 303-492-6163, ATTN: Solar-D

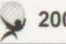

2005 National Solar Decathlon - Washington, DC

Title: TRANSVERSE SECTIONS

Revisions (Name/Date):		Date:
K FIELD	07/31/05	6/9/05
CRUZ	8/15/05	Drawn by: MC
		Checked By: JH

A4.3

Sheet 13 of 22