




East wall  
steel plates

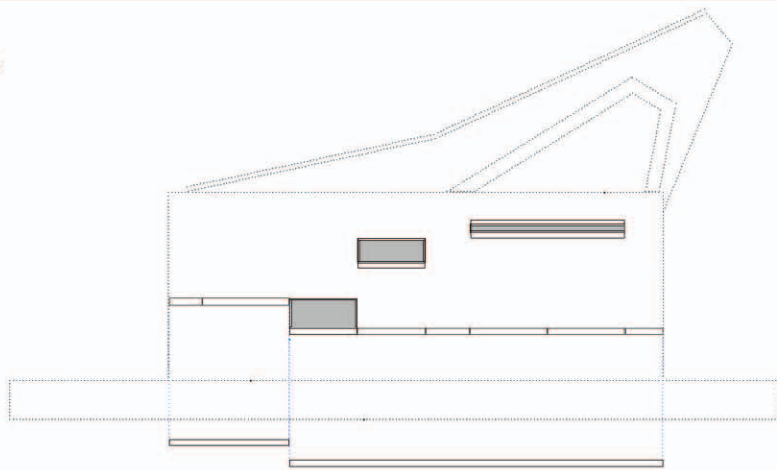


Measures

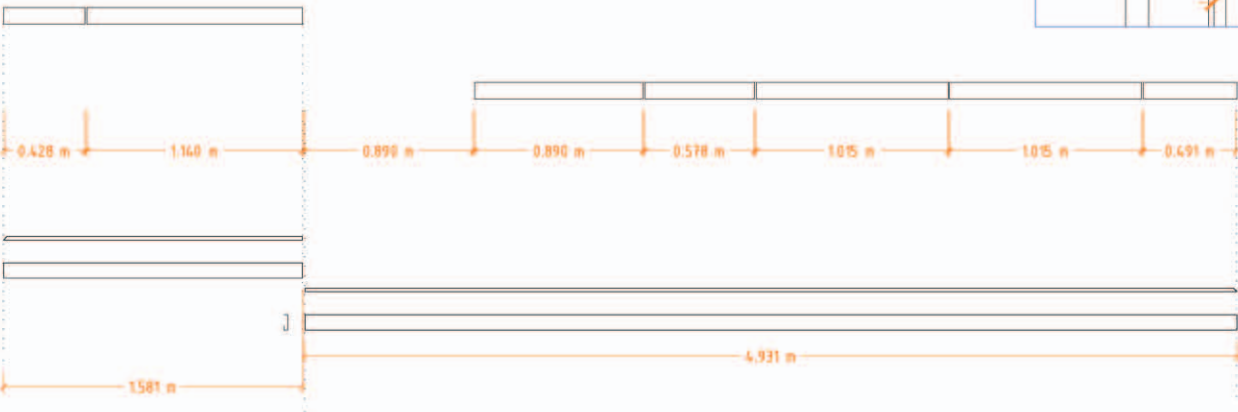


- 1-Stainless steel plate
- 2-Stainless steel clip for clay tiles
- 3-Clay tiles
- 4-OSB panel

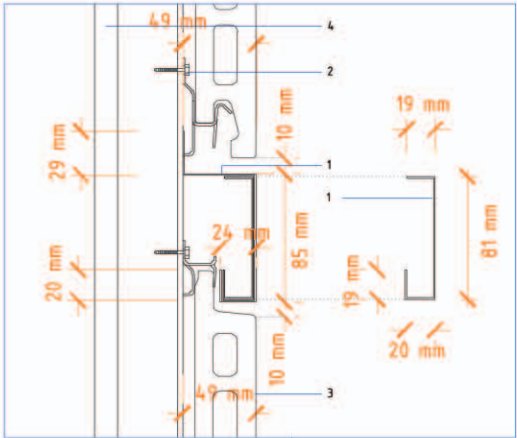

West wall  
steel plates

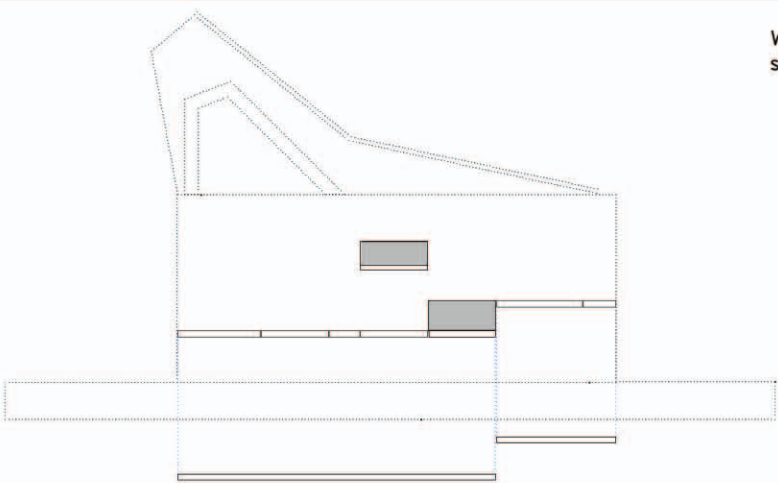


Measures

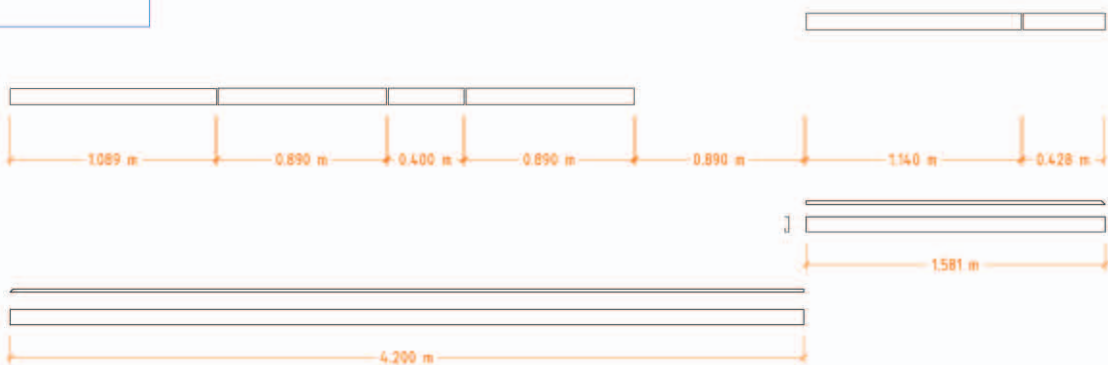


South walls  
steel plates

Measures

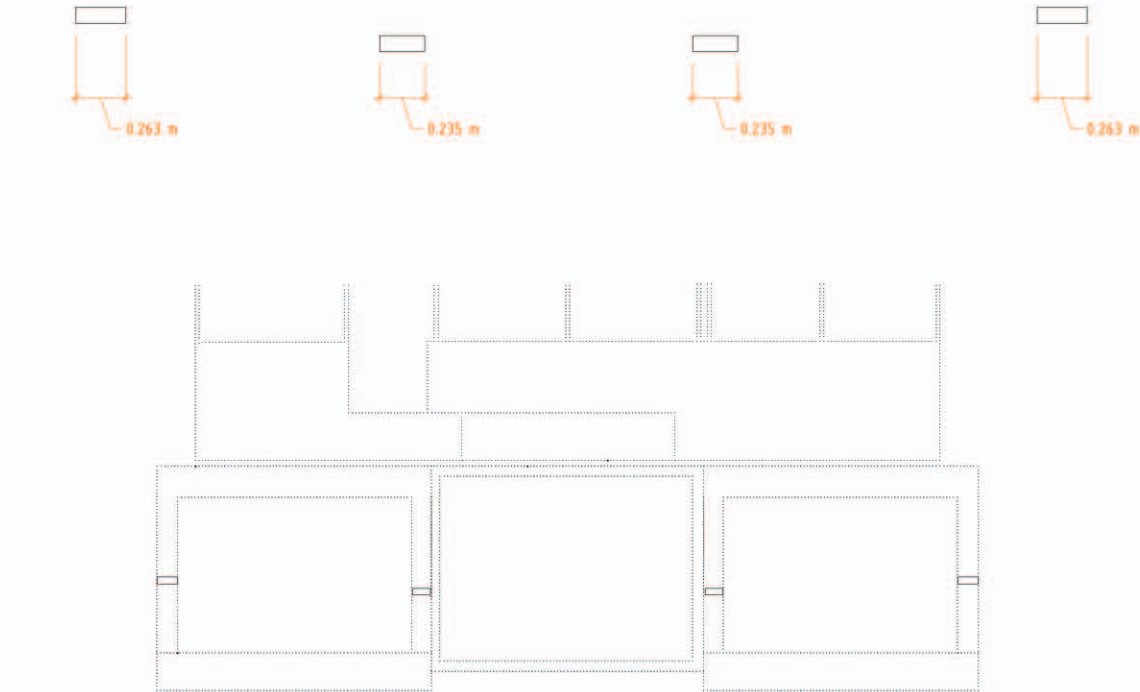

North walls  
steel plates

Measures

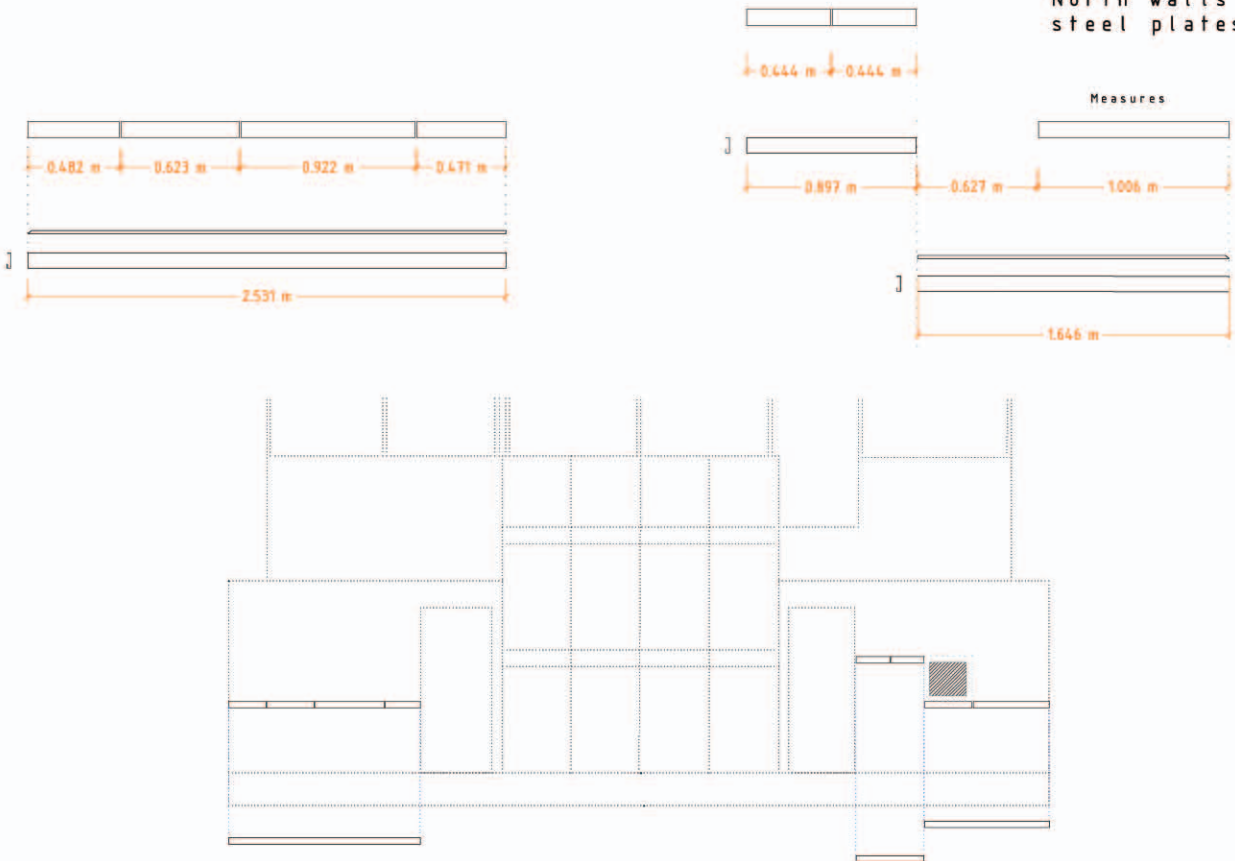

BC - 45

DATE: 08.04.2005



04/05

BC - 45

SEVERAL SCALES

SCALE\_1:10  
SCALE\_1:40  
SCALE\_1:200

SEVERAL SCALES

DANIEL CARDOSO  
plan designer  
CARLOS BERMEJO  
design coordinator  
MIGUEL GOMEZ  
general coordinator

ALFONSO GARCIA-SANTOS  
construction manager  
JAVIER NEILA  
architecture manager  
ESTEFANIA CAAMAÑO  
general coordinator



Intelling under the sun  
Universidad Politécnica de Madrid (UPM)

EXTERIOR FINISH: METAL TRACKS