



SUMMER NIGHT - SECTION F

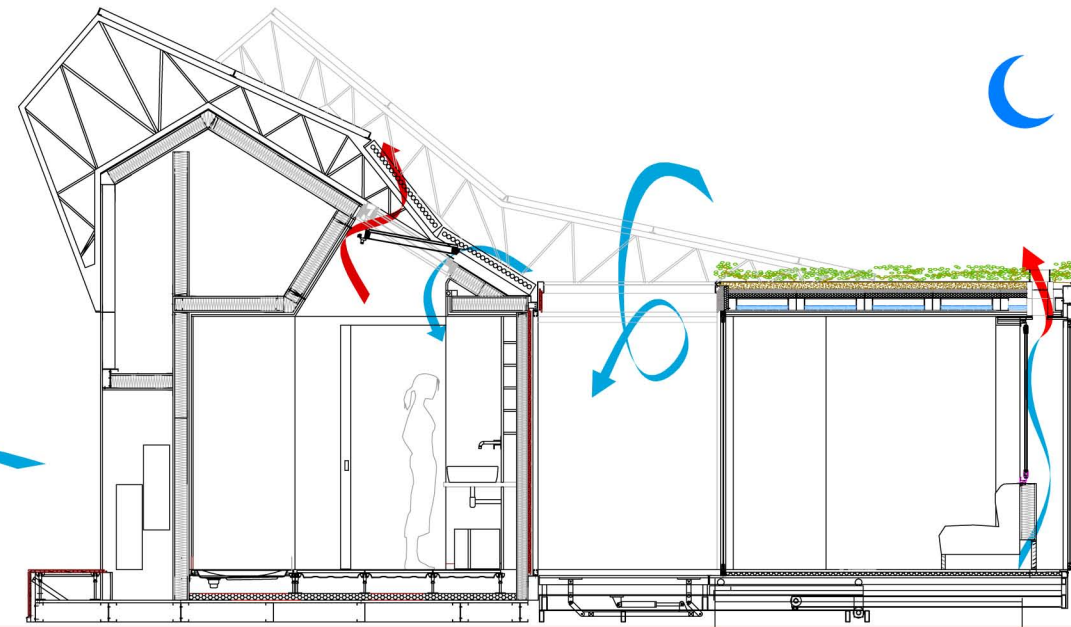

SUMMER NIGHT - SECTION D

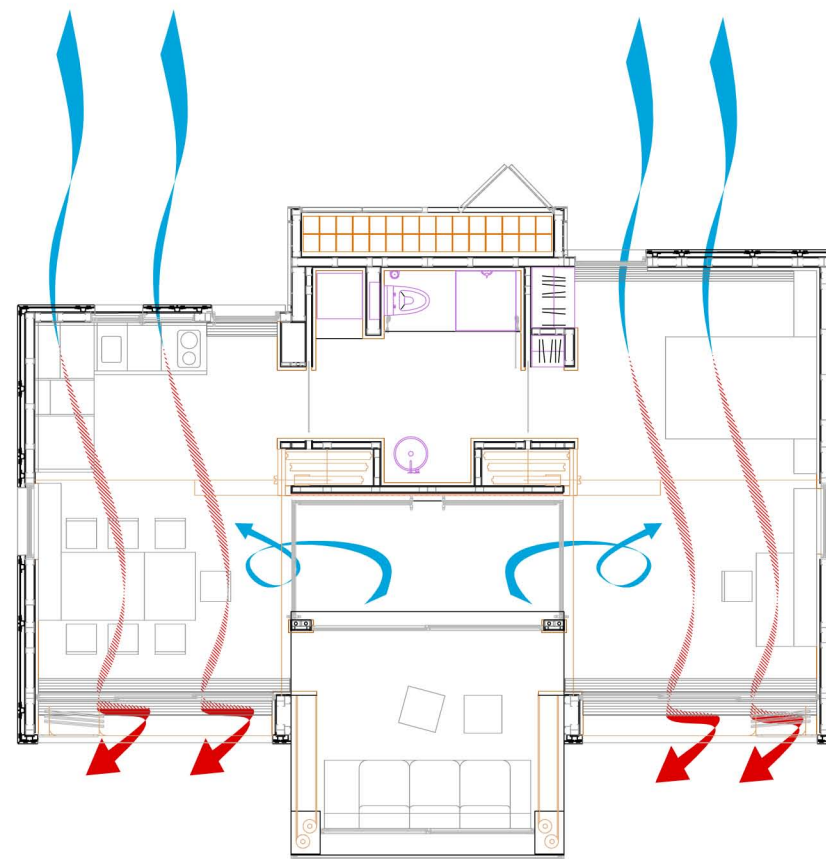


SUMMER NIGHT - PLAN



BD - 25

DATE: 08.04.2005

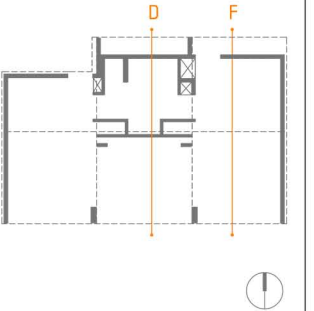

SEVERAL SCALES

SCALE_1:50
SCALE_1:100

COORDINATORS SUPERVISORS DECATHLETES

CARLOS BERMEJO
plan designer

CARLOS BERMEJO
design coordinator

MIGUEL GOMEZ
general coordinator

ALFONSO GARCIA-SANTOS
construction manager

JAVIER NEILA
architecture manager

ESTEFANIA CAAMAÑO
general coordinator

1° F

02/03

BD - 25

SEVERAL
SCALES

BIOCLIMATIC WORKING: SUMMER

