



AREA 2 OSB SLOPED ROOF PANELS (BATHROOM LAYOUT)


OSB ROOF PANELS (B)

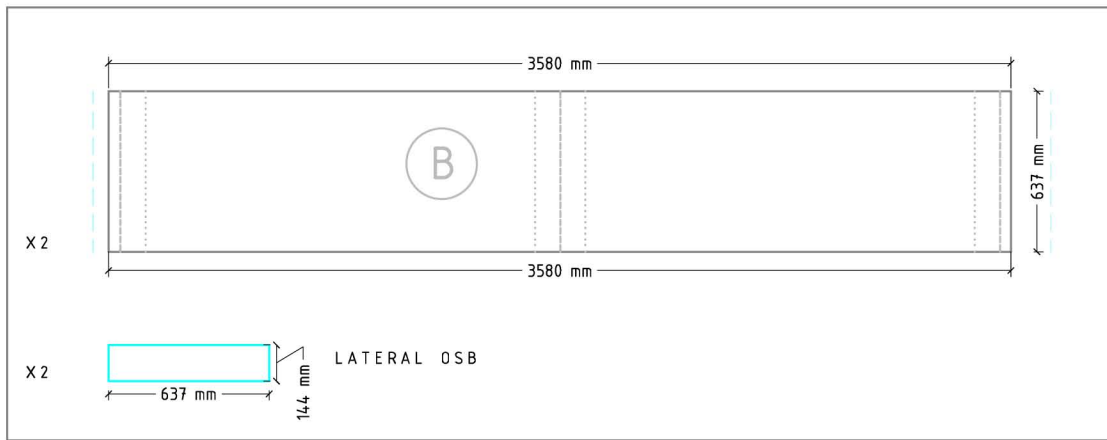


OSB ROOF PANELS (A)

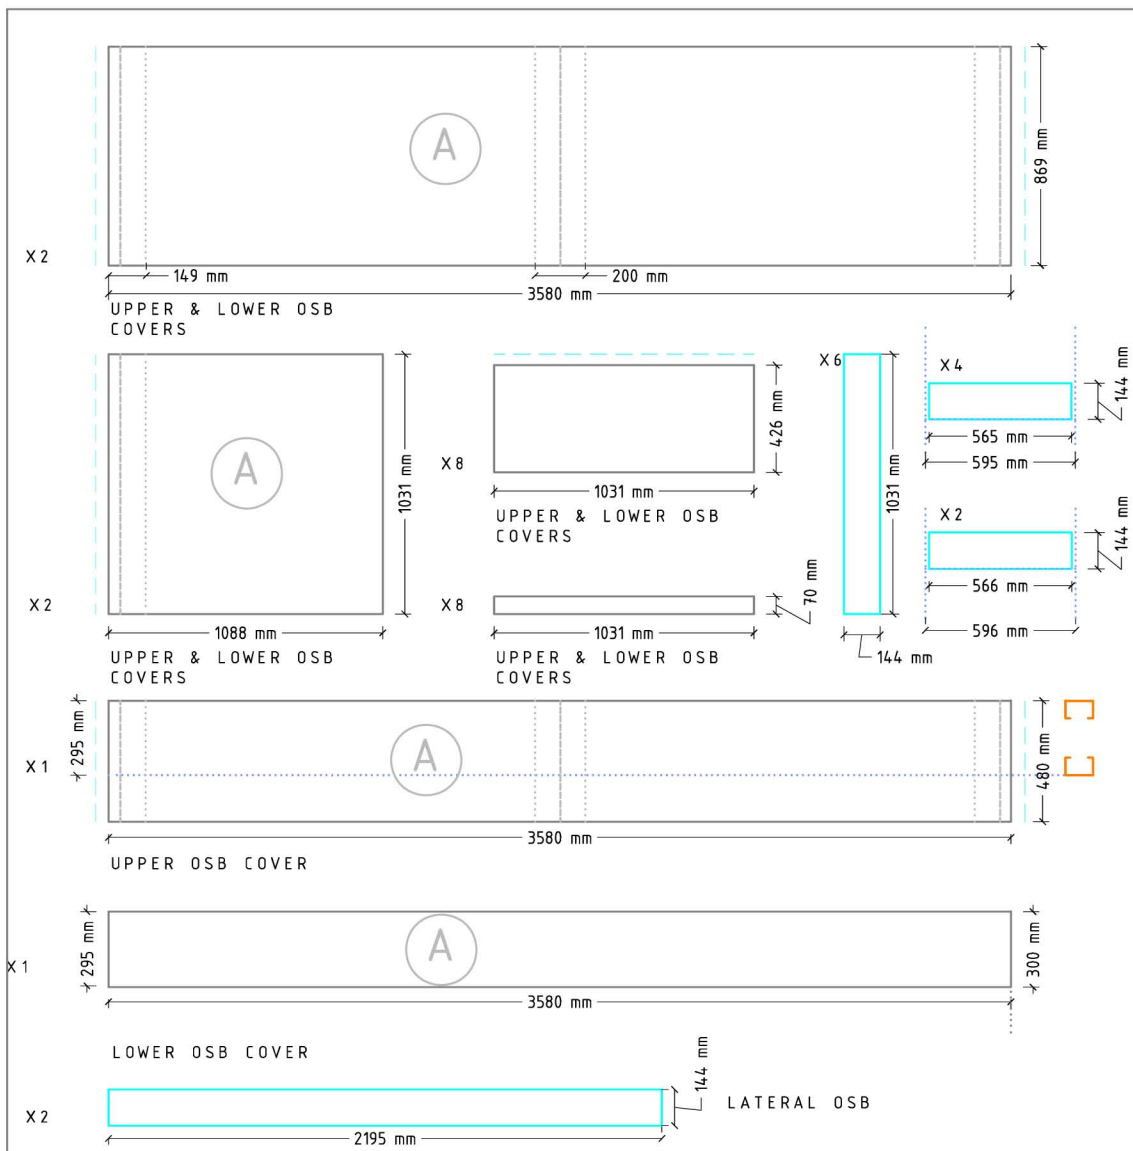

(B)

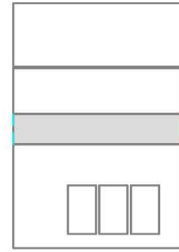


©

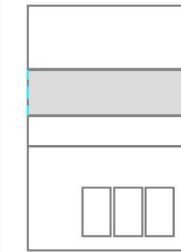

(A)




OSB ROOF PANELS (C)

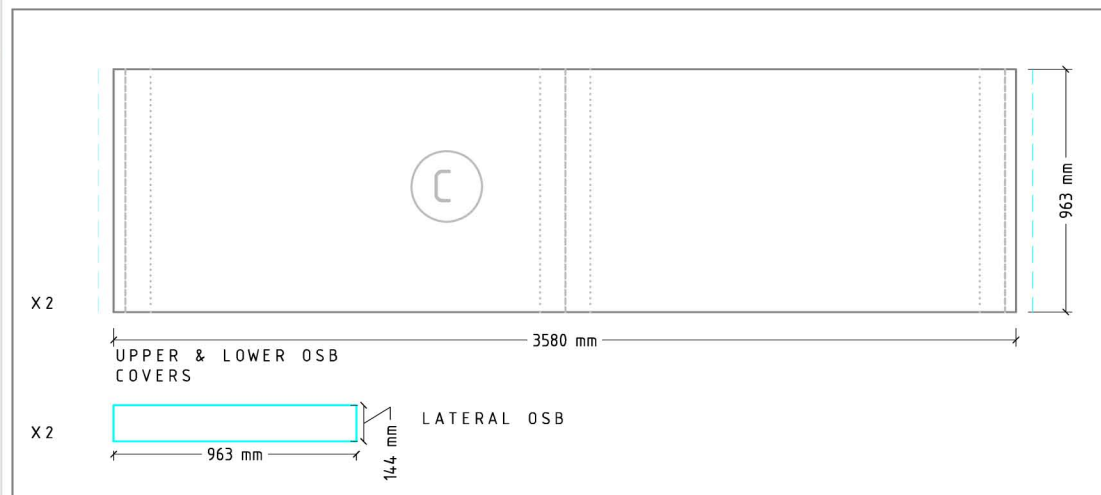


S - 22

DATE: 08.04.2005

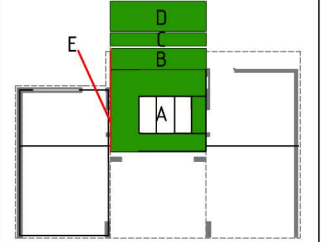

SCALE_1:30

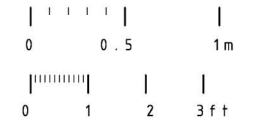

D E C A T H L E T E S

LETICIA RO-BER
plan designer

CARLOS BERMEJO
design coordinator

MIGUEL GOMEZ
general coordinator

COORDINATORS

JOE WORCESTER
professional engineer

ALFONSO GARCÍA-SANTOS
construction manager

JAVIER NEILA
architecture manager

ESTEFANÍA CAAMAÑO
general coordinator



Universidad Politécnica de Madrid (UPM)

07/10

77-5

1:30

USB PANELS: ROOF LAYOUT