

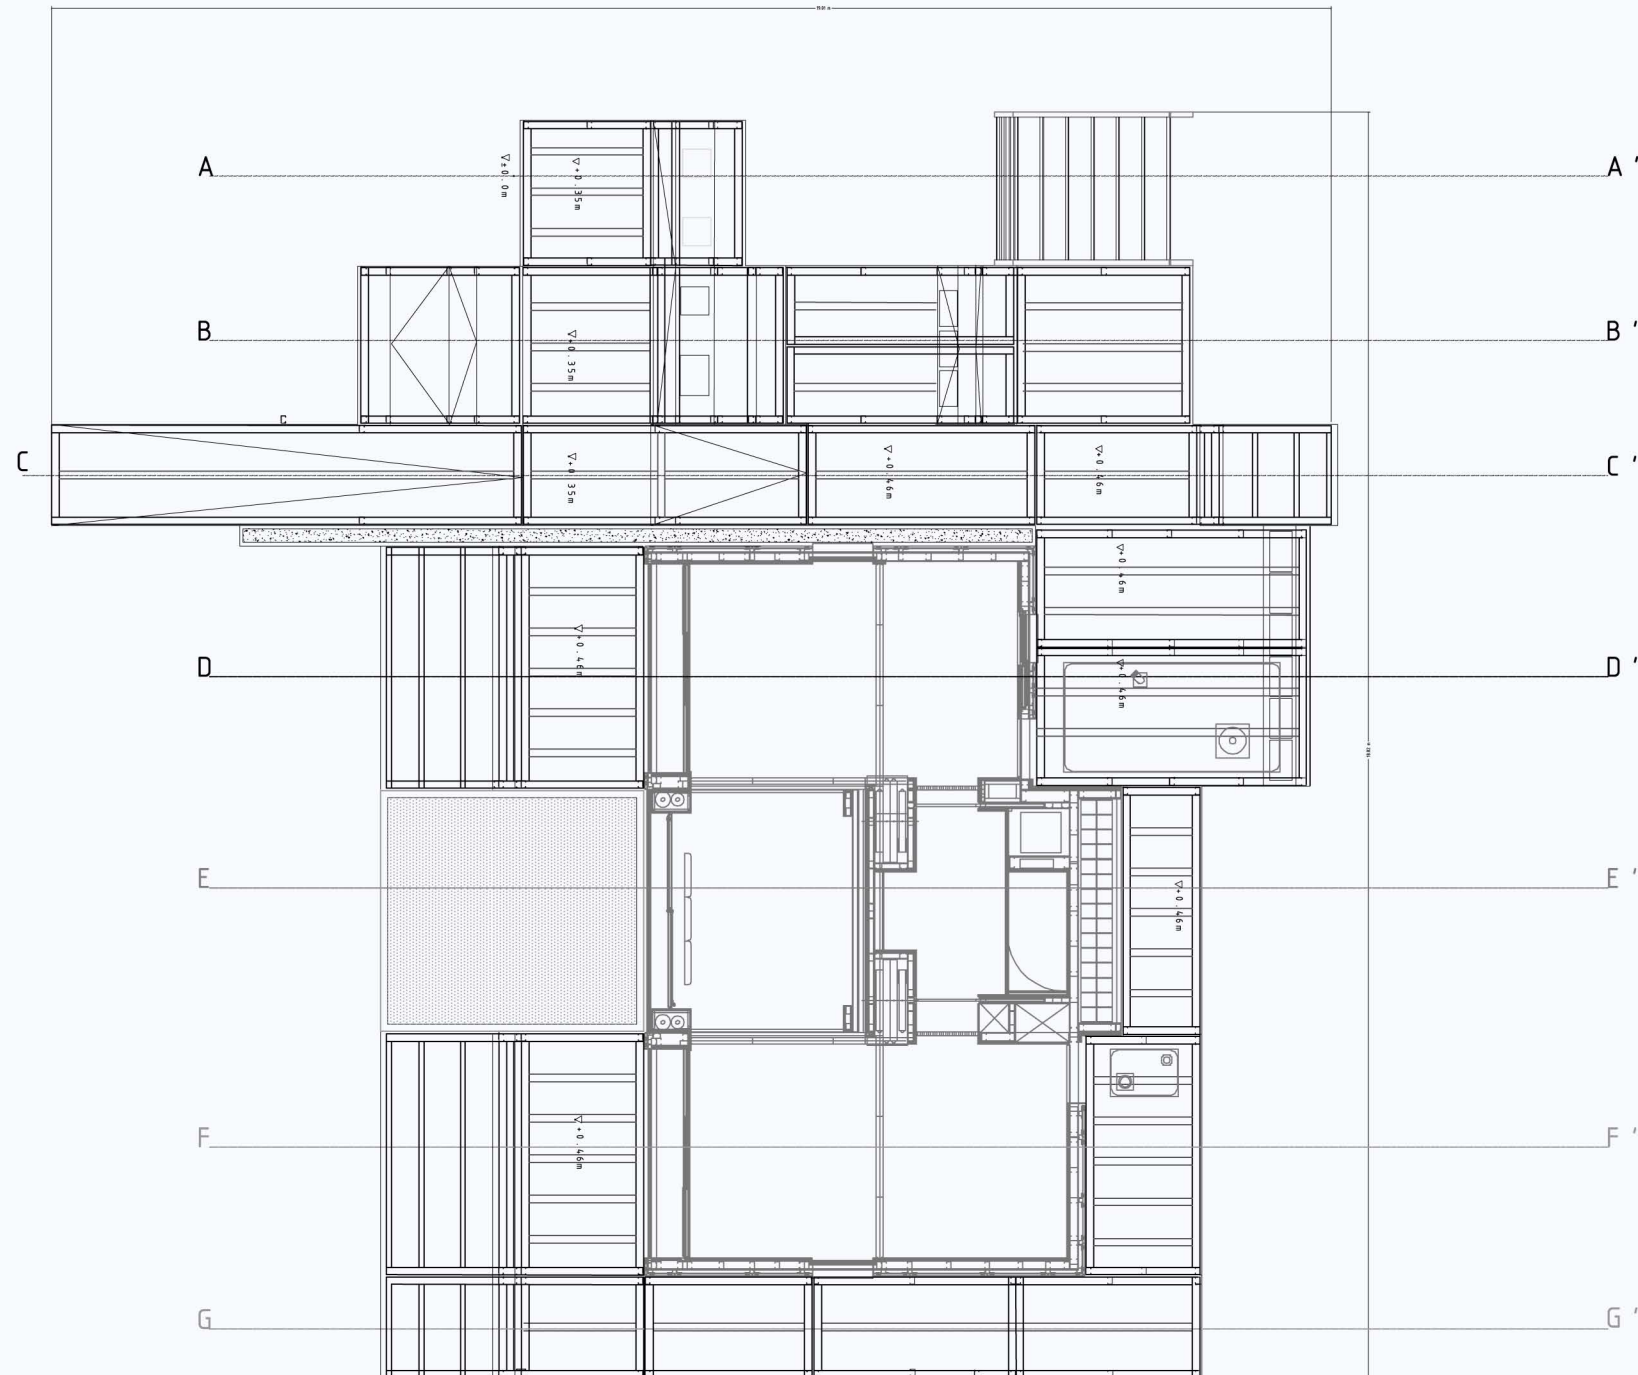


OUTDOOR AREAS

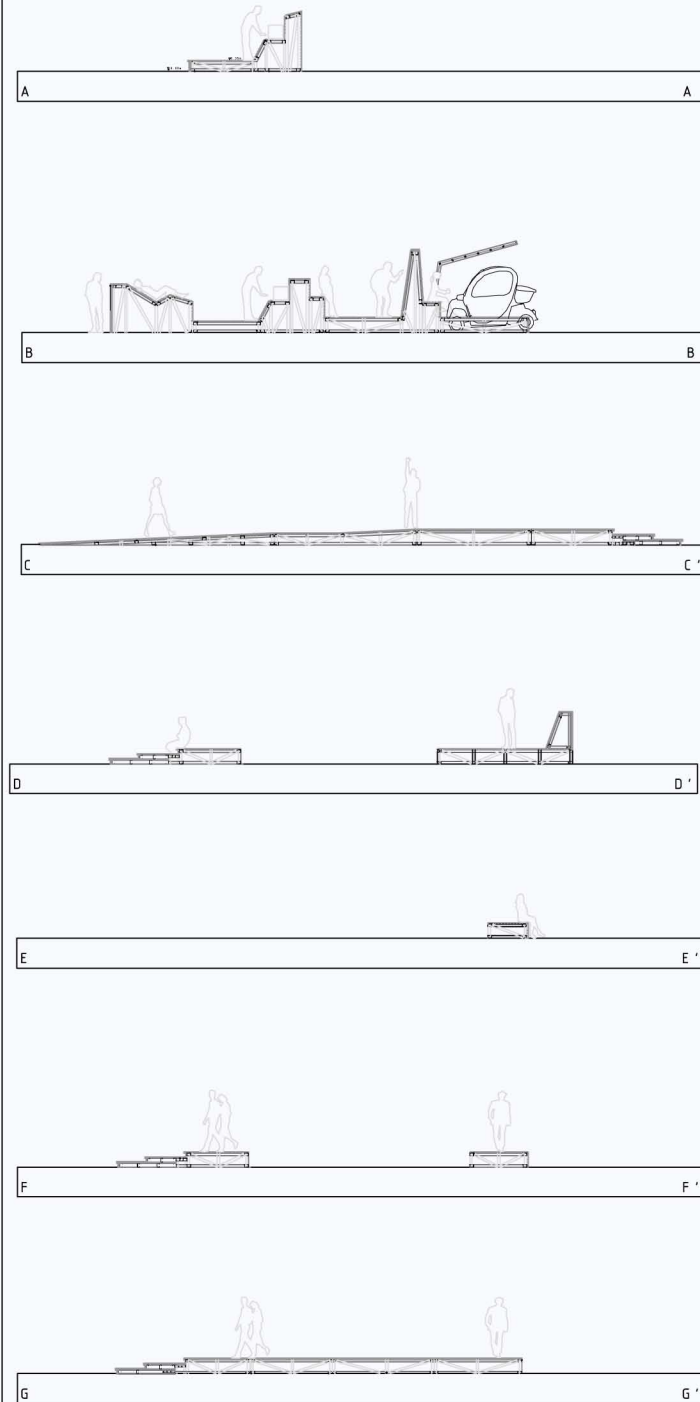

BC - 48

DATE: 08.04.2005

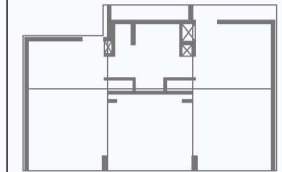

SEVERAL SCALES

SCALE _ 1:250

SCALE _ 1:100

MERCEDES PEÑA
ISABEL MONTANÉS
plan designer

CARLOS BERMEJO
design coordinator

MIGUEL GOMEZ
general coordinator

JOE WORCESTER
professional engineer

ALFONSO GARCIA-SANTOS
construction manager

JAVIER NEILA
architecture manager

ESTEFANIA CAAMAÑO
general coordinator



unfolding under the sun
Universidad Politécnica de Madrid (UPM)

01/01

BC - 48

OUTDOOR AREAS