



AREA 1

OSB SLOPED ROOF PANELS (KITCHEN LAYOUT)


OSB ROOF PANELS (F)

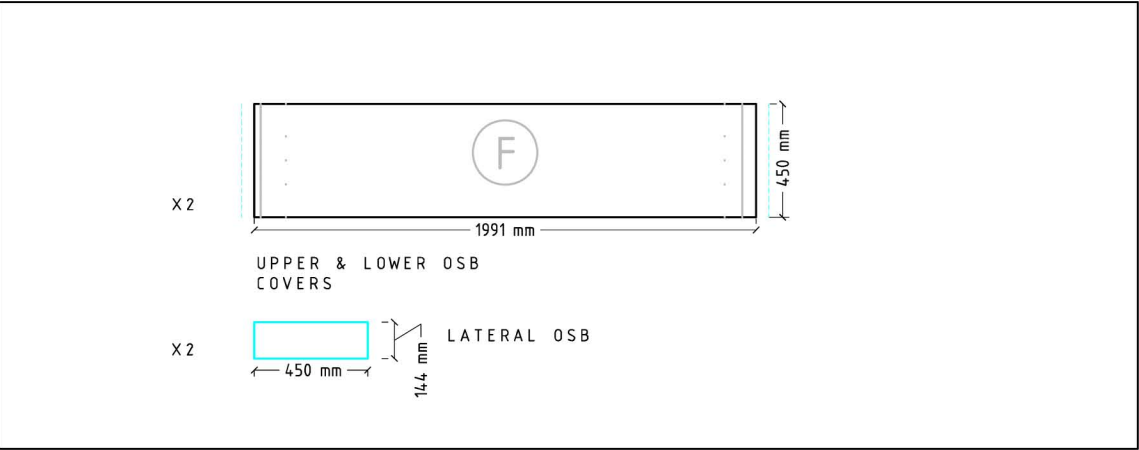


F

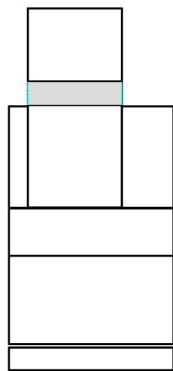


G

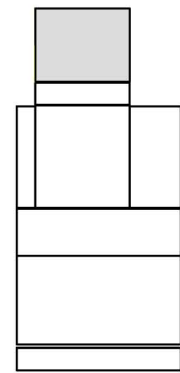


OSB ROOF PANELS (E)

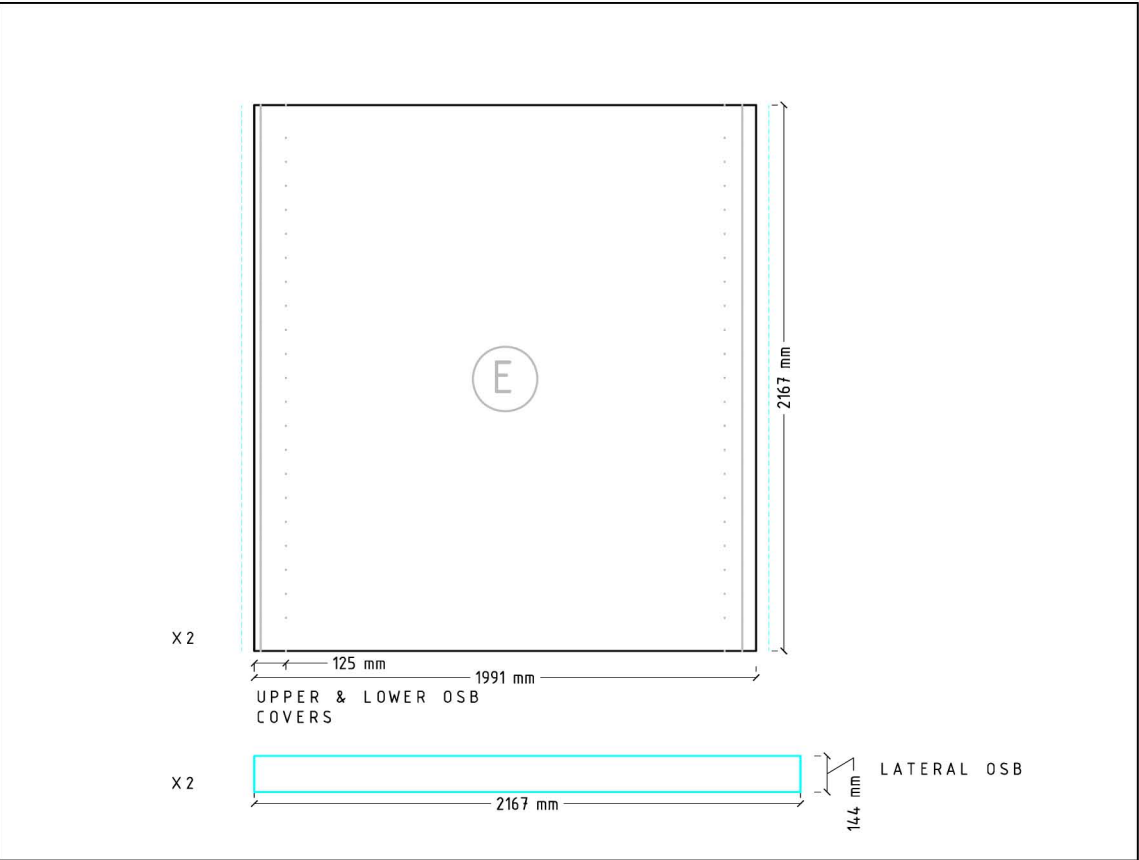

E

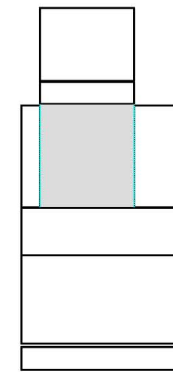


OSB ROOF PANELS (G)

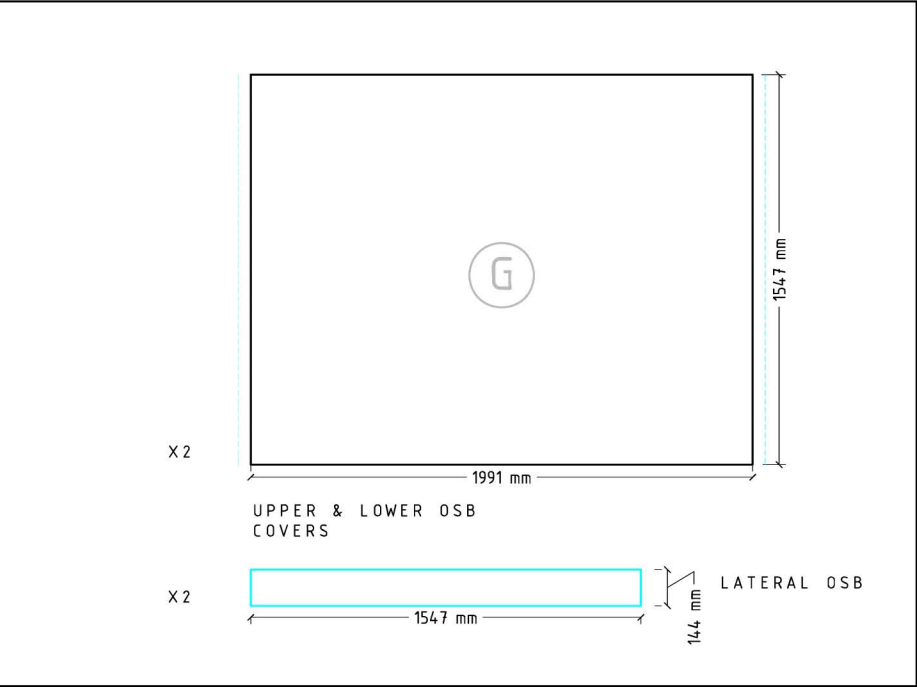

S - 22

DATE : 08.04.2005

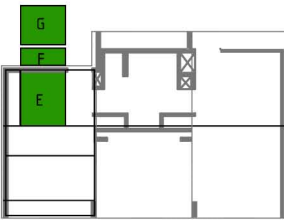

SCALE\_1 : 30



LETICIA RO-BER  
plan designer

CARLOS BERMEJO  
design coordinator

MIGUEL GOMEZ  
general coordinator

JOE WORCESTER  
professional engineer

ESTEFANIA CAAMAÑO  
general coordinator

JAVIER NEILA  
architecture manager

ALFONSO GARCIA-SANTOS  
construction manager



03 / 10

S - 22

1 : 30

OSB PANELS : ROOF LAYOUT