

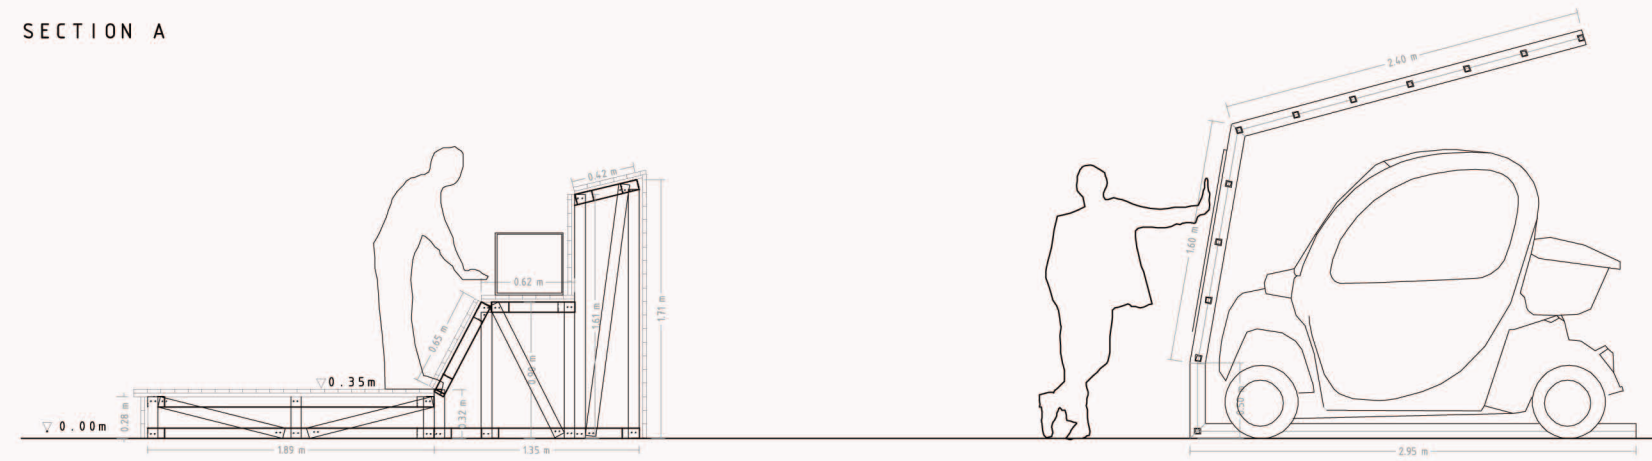


SECTION A

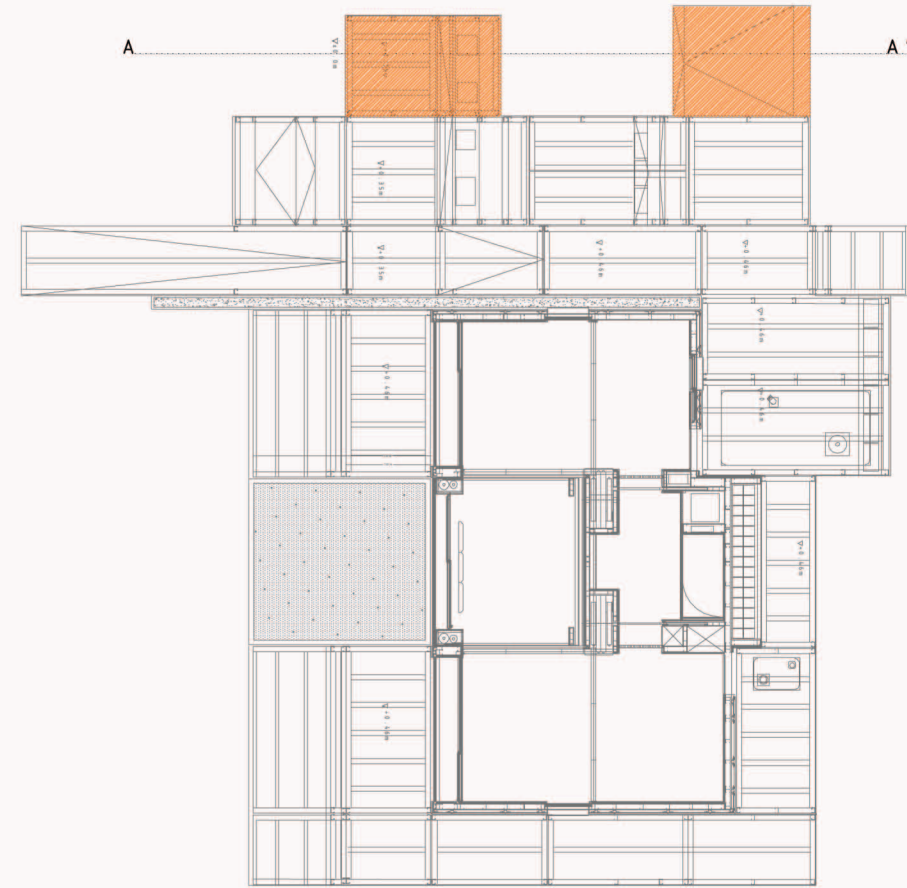

E 1/50
TOP A

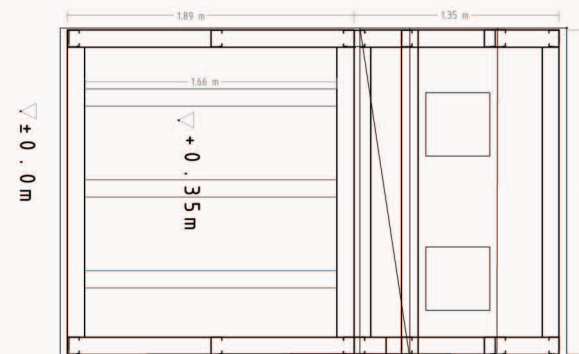

GENERAL PLAN

STRUCTURE _____ STEEL BUILT



WOODEN STRIPS


WOODEN SECONDARY STRUCTURE

CLIP

□ Ø 110


□ Ø 112

SCALE 1:5

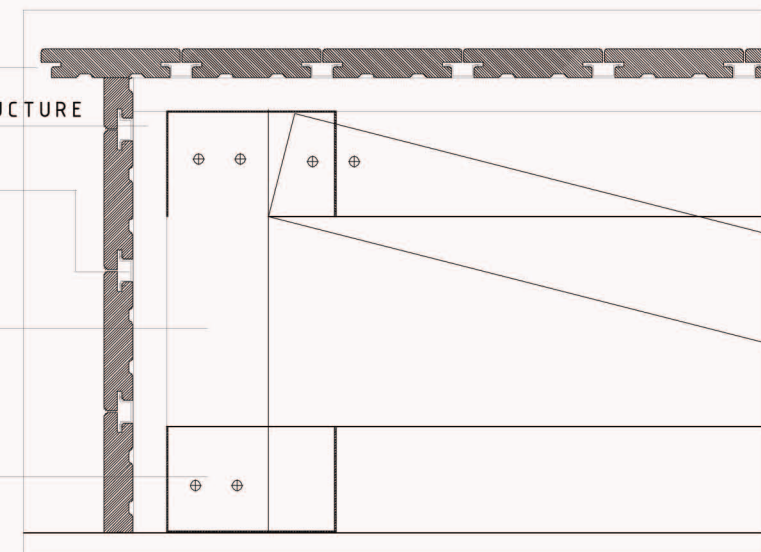

BC - 49

DATE: 08.04.2005

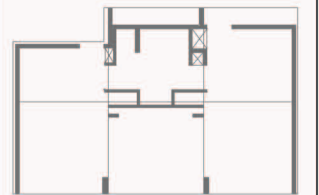

SEVERAL SCALES

SCALE_ 1:5

SCALE_ 1:50

MERCEDES PEÑA
ISABEL MONTANÉS
plan designer

CARLOS BERMEJO
design coordinator

MIGUEL GOMEZ
general coordinator

JOE WORCESTER
professional engineer

ALFONSO GARCIA-SANTOS
construction manager

JAVIER NEILA
architecture manager

ESTEFANIA CAAMAÑO
general coordinator



Unifolding under the sun
Universidad Politécnica de Madrid (UPM)

01/07

BC - 49

OUTDOOR AREAS