



BC - 29

DATE: 08.04.2005

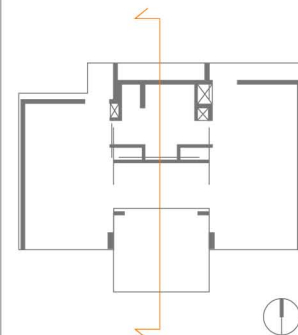

SCALE_1:40

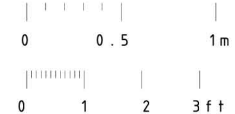

01/01

BC - 29

1:40

SECTION D: BATHROOM (UNFOLDED)

- COORDINATORS SUPERVISORS DECATHLETES
- CARLOTREZZO
plan designer
 - CARLOS BERMEJO
design coordinator
 - MIGUEL GOMEZ
general coordinator
 - JOE WORCESTER
professional engineer
 - ALFONSO GARCIA-SANTOS
construction manager
 - JAVIER NEILA
architecture manager
 - ESTEFANIA CAAMAÑO
general coordinator



unfolding under the sun
Universidad Politécnica de Madrid (UPM)