




- OVERHEATING PROTECTION
- VENTILATED VEGETATION
- VENTILATED AREA
- INSULATION
- PROTECTED AREA

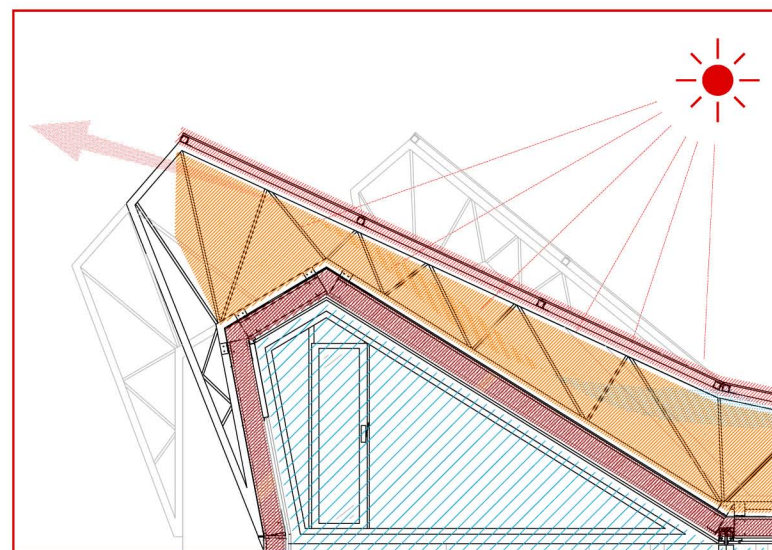


DETAIL A

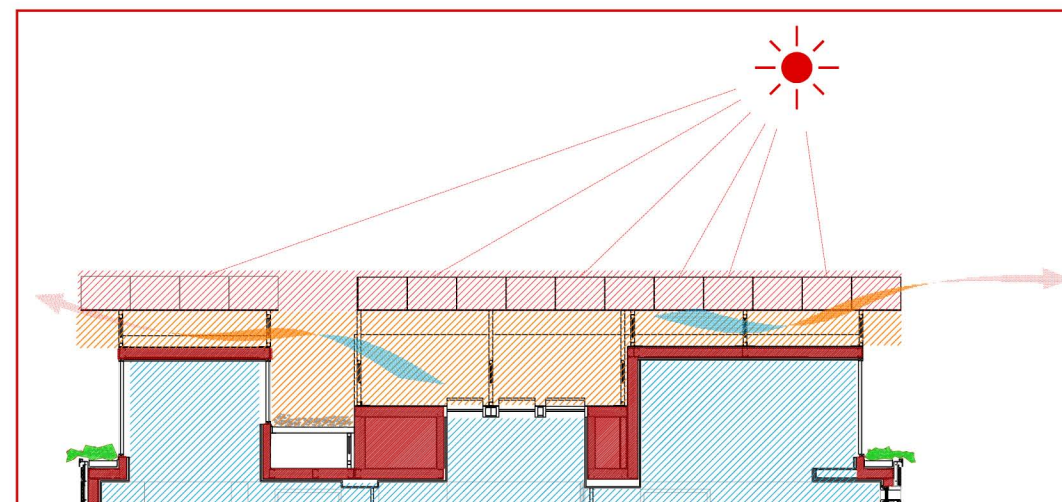


DETAIL E

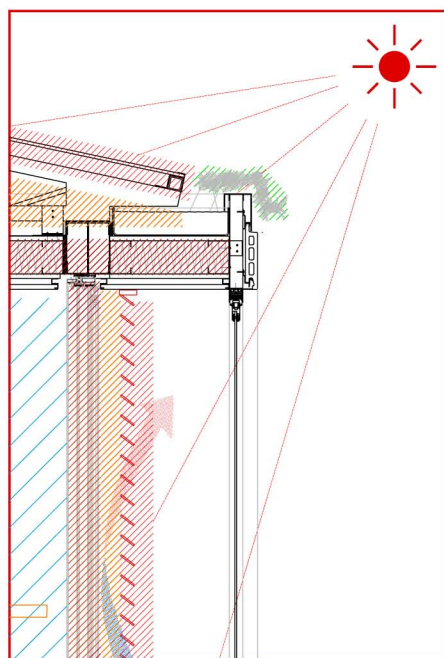


DETAIL B

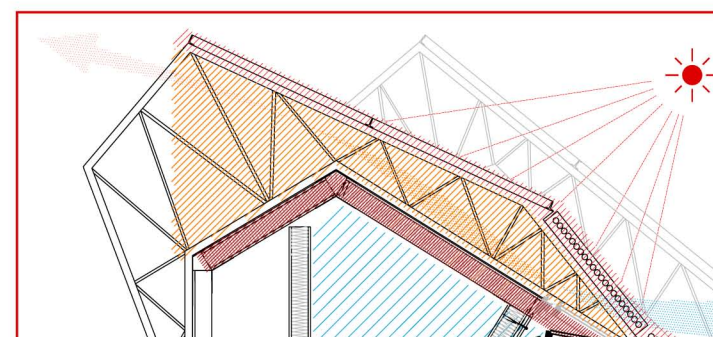


DETAIL C

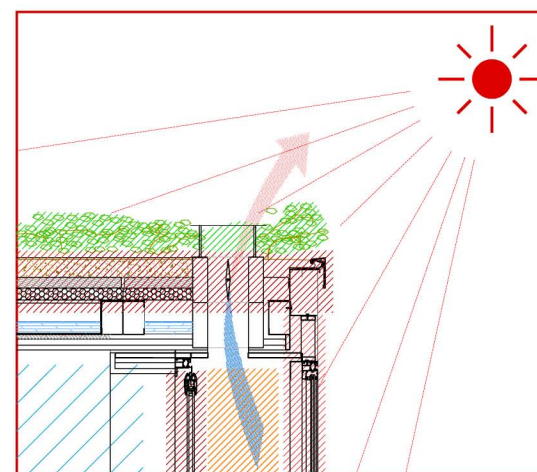


DETAIL D

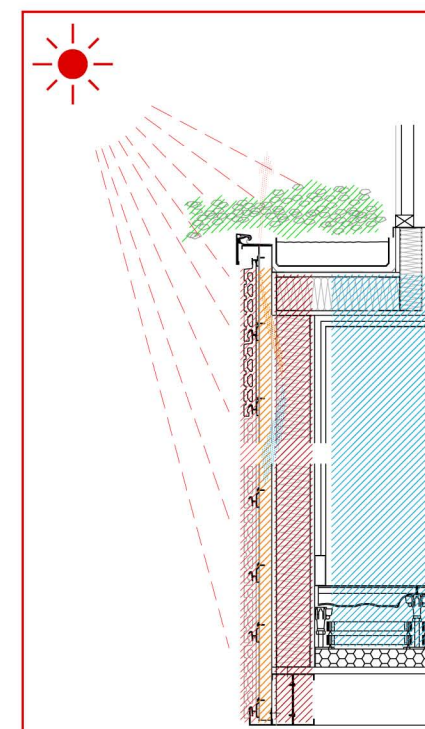


DETAIL F

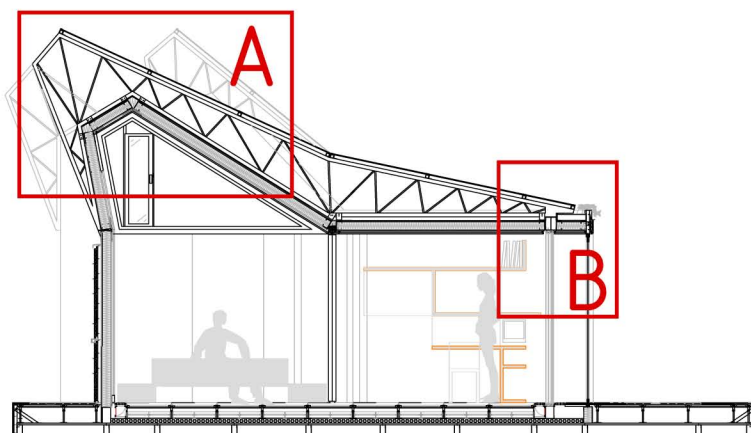

SECTION F

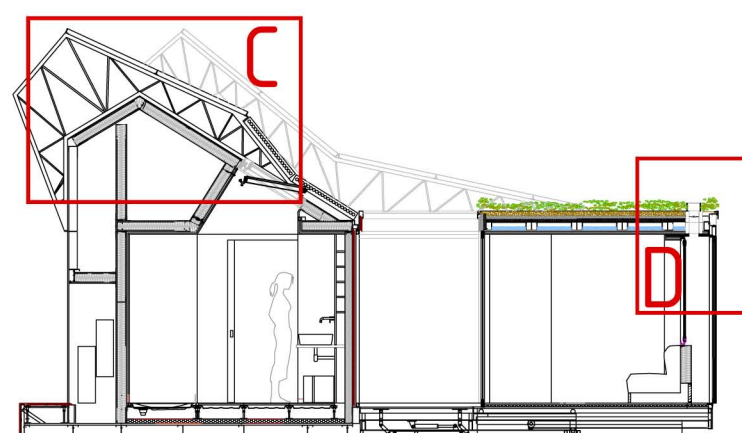

SECTION D

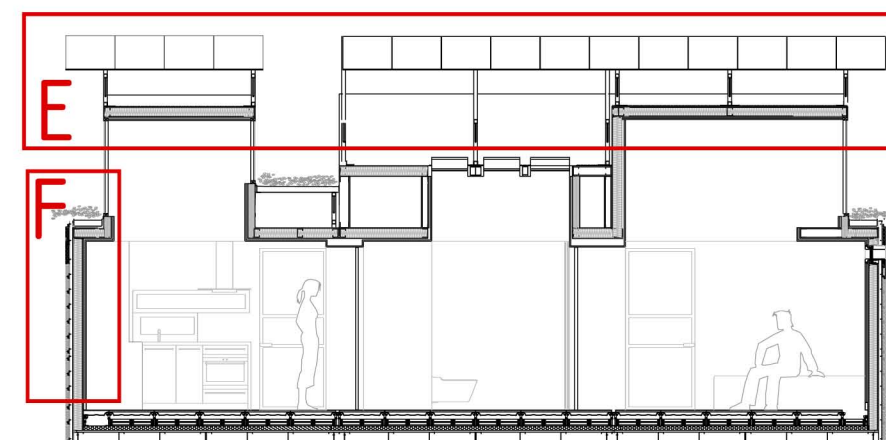


SECTION G



BD - 24

DATE: 08.04.2005

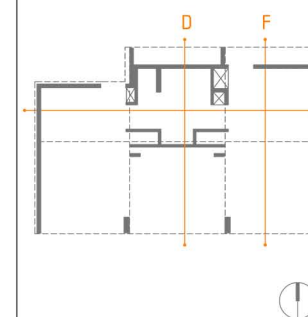

SEVERAL SCALES

SCALE_1:30
SCALE_1:50
SCALE_1:100

CARLOS BERMEJO
plan designer

CARLOS BERMEJO
design coordinator

MIGUEL GOMEZ
general coordinator

ALFONSO GARCIA-SANTOS
construction manager

JAVIER NEILA
architecture manager

ESTEFANIA CAAMAÑO
general coordinator



unfolding under the sun
Universidad Politécnica de Madrid (UPM)

BD - 24

05/06

BD - 24

SEVERAL SCALES

OVERHEATING PROTECTION