


Wall top edge	+3.07m
Clay tiles top edge	+3.00m
Steel framing top edges	+2.81m
Suspended ceiling	+2.77m

## OSB Panels

Oriented Strand Boards  
2500x1250x15mm

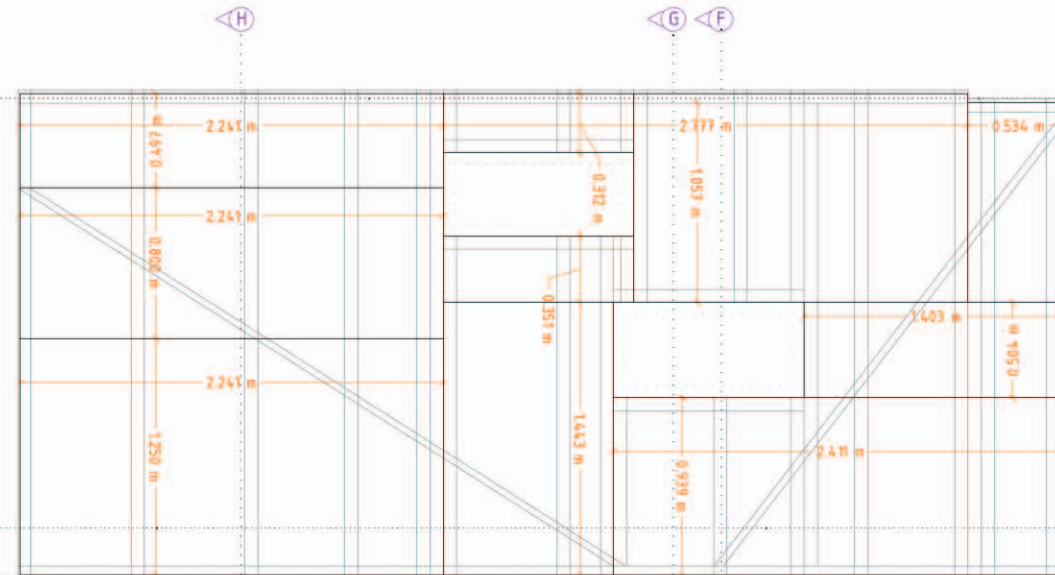

1\_Oriented Strand Boards  
2500x1250x15mm


2\_Stainless Steel Structure

### Levels:

Wall top edge	+3.000m
Clay tiles top edge	+2.916m
Steel framing top edges	+2.231m
Suspended ceiling	+2.895m


## Steel framing

- ☐ Galvanized steel  
C-shaped profile:  
110x70x20x1mm.
- ☐ Galvanized steel  
U-shaped profile:  
114x70x1mm.

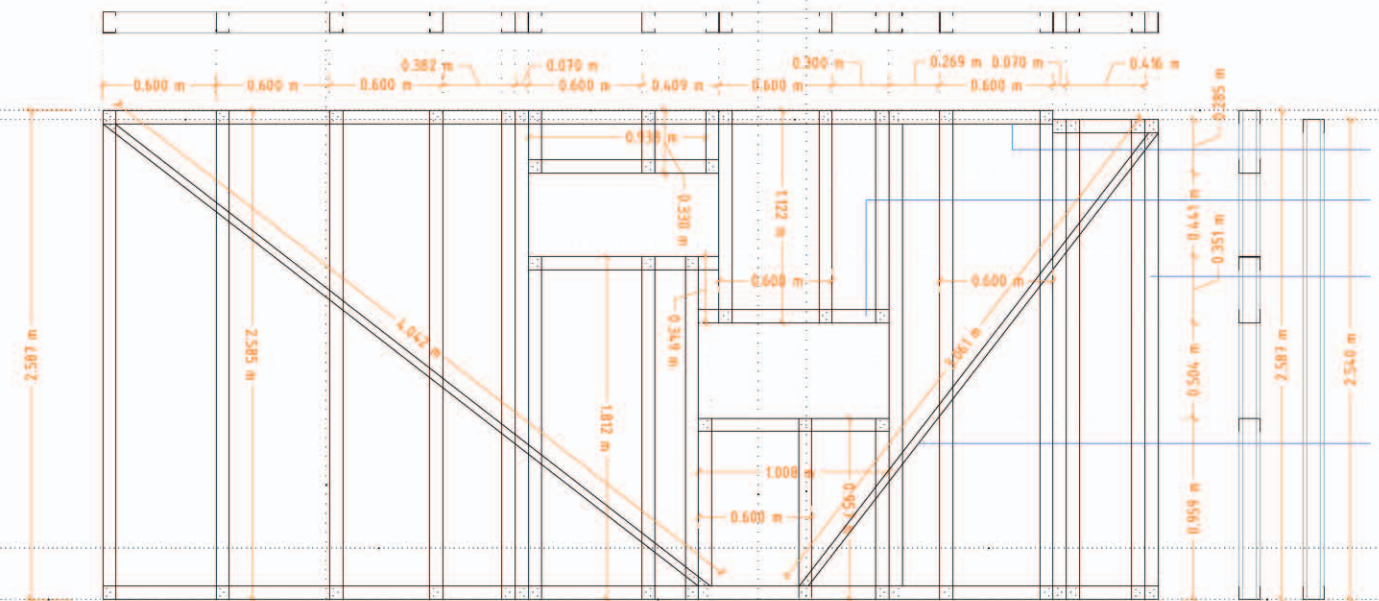


- 1 Tracks
- 2 Load-bearing header
- 3 Load-bearing stud
- 4 Diagonal strap bracing
- 5 Rounded head Screws 5mm diameter

Load-bearing wall A

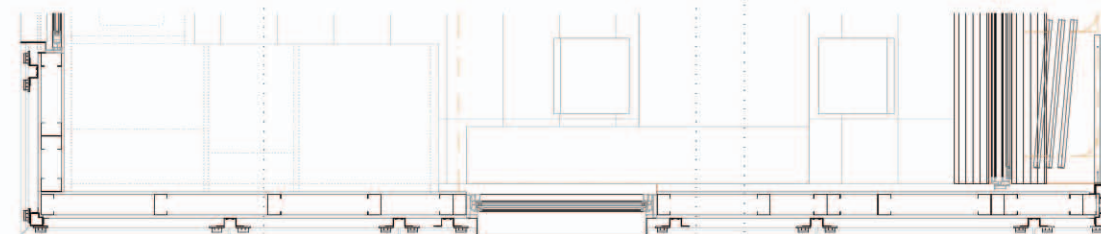


S - 20

DATE: 08.04.2005

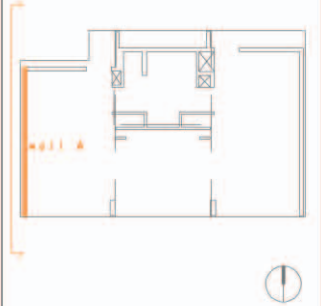

SCALE 1:40

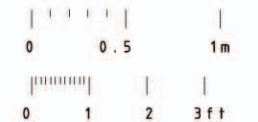

COORDINATORS	SUPERVISORS	DECATHLETES
1	1	1
2	2	2
3	3	3
100	100	100

DANIEL CARDOSO  
plan designer

CARLOS BERMEJO  
design coordinator

MIGUEL GOMEZ  
general coordinator

**JOE WORCESTER**  
professional engineer

**ALFONSO GARCIA-SANTOS**  
construction manager

**JAVIER NEILA**  
architecture manager

ESTEFANIA CAAMAÑO  
general coordinator



Universidad Politécnica de Madrid (UPM)

01/07

S-20

1:40

MAIN STRUCTURE: WEST WALL