


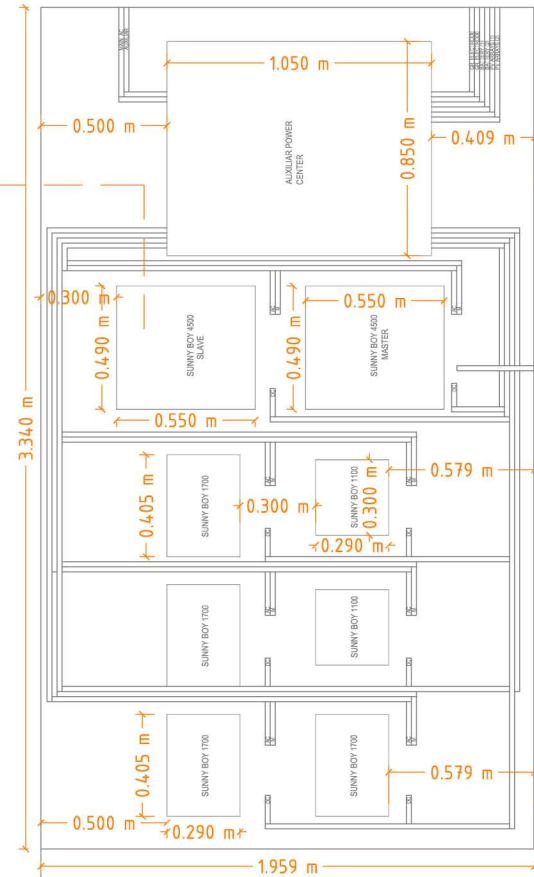

INVERTERS



30 BATTERIES


FIRE EXTINGUISHER



RACK




BATTERIES

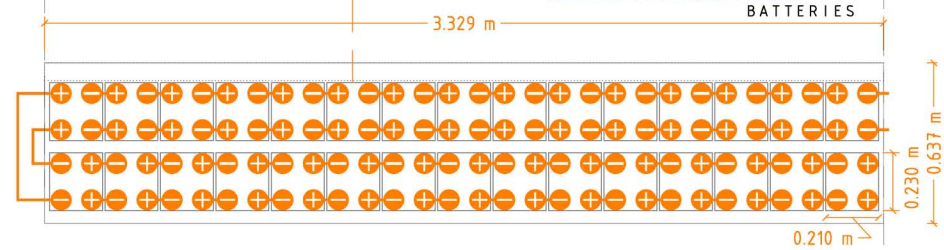


E - 51

DATE: 08.04.2005

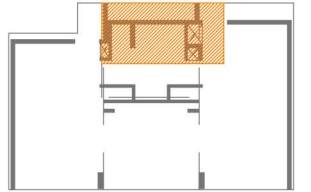

SCALE_1:30

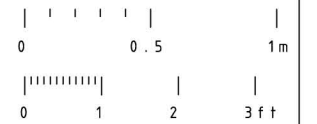

04/05

E - 51

1:30

COORDINATORS SUPERVISORS DECATHLETES

CARLOTREZZO
plan designer

MARCOS CALVO
design coordinator



ANTONIO VILLANUEVA
IDOM industrial engineer

ALFONSO GARCIA-SANTOS
construction manager

JAVIER NEILA
architecture manager

ESTEFANIA CAAMAÑO
general coordinator

PV EQUIPMENT ROOM

