


S - 21

DATE: 08.04.2005



SCALE\_1:20

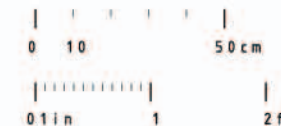

COORDINATORS SUPERVISORS DECATHLETES

LUIS CLIMENT  
plan designer

CARLOS BERMEJO  
design coordinator

MIGUEL GOMEZ  
general coordinator

JOE WORCESTER  
professional engineer

ESTEFANIA CAAMAÑO  
general coordinator

JAVIER NEILA  
architecture manager

ALFONSO GARCIA-SANTOS  
construction manager



unfolding under the sun  
Universidad Politécnica de Madrid (UPM)

02/07

S - 21

1:20

ROOF FRAMING: TRUSS A