


DAY 1


ASSEMBLED ELEMENT
MOVABLE MODULE
PACKING LIST REFERENCE
1.4.1.2
ESTIMATED TIME OF ASSEMBLY
1 HOUR




WEST ELEVATION

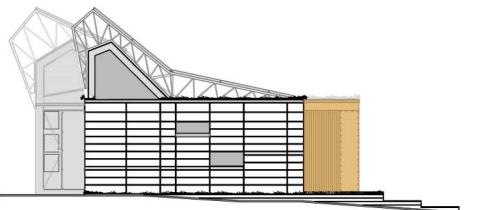

NORTH ELEVATION

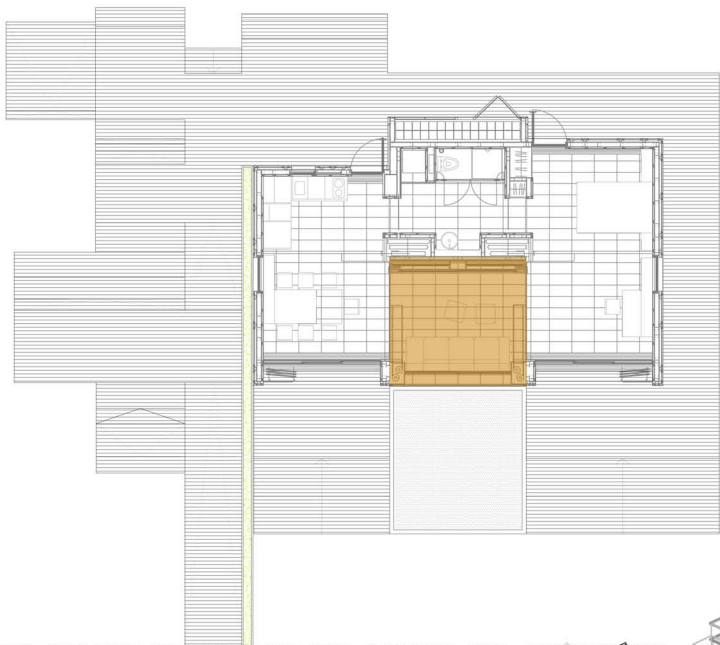

CROSS SECTION

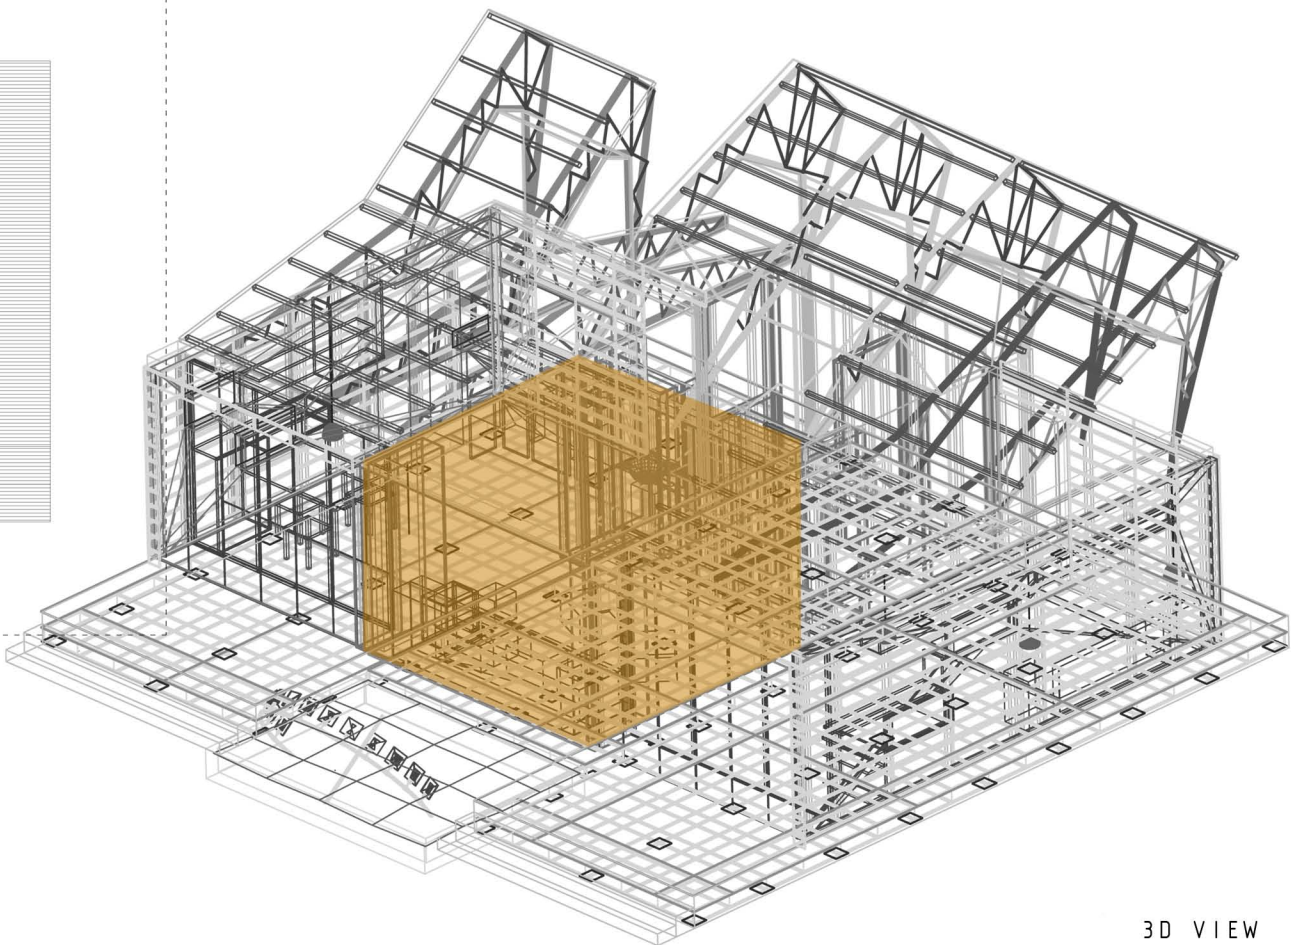

3D VIEW




AD-59

DATE: 08.04.2005



SCALE 1:200

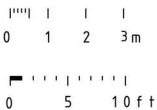

IVÁN ALCANTARILLA
plan designer
CARLOS BERMEJO
design coordinator
MIGUEL GOMEZ
general coordinator

ALFONSO GARCIA-SANTOS
construction manager
JAVIER NEILA
architecture manager
ESTEFANIA CAAMAÑO
general coordinator



unfolding under the sun
Universidad Politécnica de Madrid (UPM)



02/10

AD-59

1:200

ASSEMBLY

