


S-21

DATE: 08.04.2005

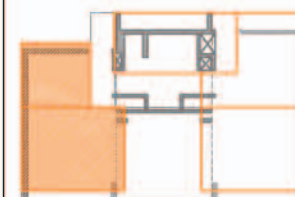

03/07

S-21

SCALE_1:20



1:20

COORDINATORS SUPERVISORS DECAATHLETES

LUIS CLIMENT
plan designer

CARLOS BERMEJO
design coordinator

MIGUEL GOMEZ
general coordinator

JOE WORCESTER
professional engineer

ESTEFANIA CAAMAÑO
general coordinator

JAVIER NEILA
architecture manager

ALFONSO GARCIA-SANTOS
construction manager

ROOF FRAMING: TRUSS B



unfolding under the sun
Universidad Politécnica de Madrid (UPM)