


Secondary framing

Levels:

Wall top edge	+3.000m
Clay tiles top edge	+2.916m
Steel framing top edges	+2.731m
Suspended ceiling	+2.695m

- 1 Extruded aluminum furring channel
- 2 Extruded aluminum corner key
- 3 Stainless steel clip

Floor	+0.465m
Steel framing bottom edge	+0.195m
Ground level	+0.000m -0.078m

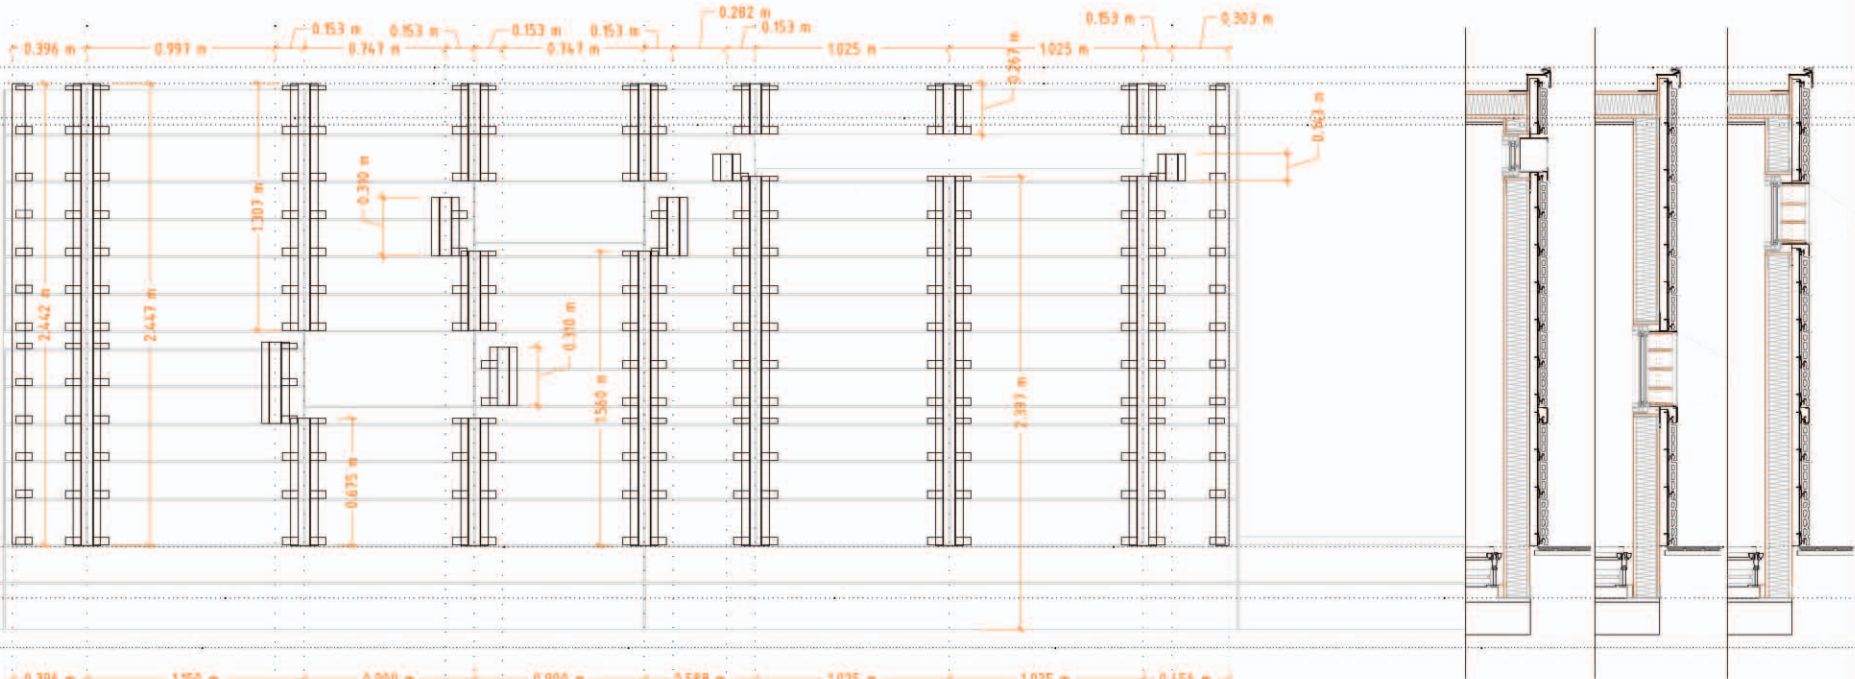

Clay tiles

Levels:

Wall top edge	+3.000m
Clay tiles top edge	+2.916m
Steel framing top edges	+2.731m
Suspended ceiling	+2.695m


- 4 Clay tile
- 5 Stainless steel plate

Floor	+0.465m
Steel framing bottom edge	+0.195m
Ground level	+0.000m -0.078m



BC - 43

DATE: 08.04.2005

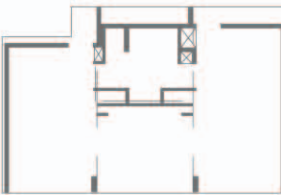

SCALE\_1:40



COORDINATORS SUPERVISORS DECATHLETES

DANIEL CARDOSO  
plan designer

CARLOS BERMEJO  
design coordinator

MIGUEL GOMEZ  
general coordinator

ALFONSO GARCIA-SANTOS  
construction manager

JAVIER NEILA  
architecture manager

ESTEFANIA CAAMAÑO  
general coordinator



Intelling under the sun  
Universidad Politécnica de Madrid (UPM)

03/04

BC - 43

1:40

EXT.FINISH:CLAY TILES - EAST