


DAY 3 to 7

ASSEMBLED ELEMENT  
INSTALATIONS

PACKING LIST REFERENCE  
1.10, 1.11, 1.13, 1.15, 1.16


ESTIMATED TIME OF ASSEMBLY  
12 HOURS

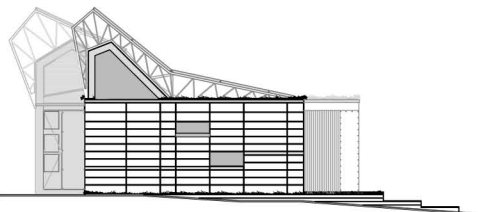


WEST ELEVATION




NORTH ELEVATION

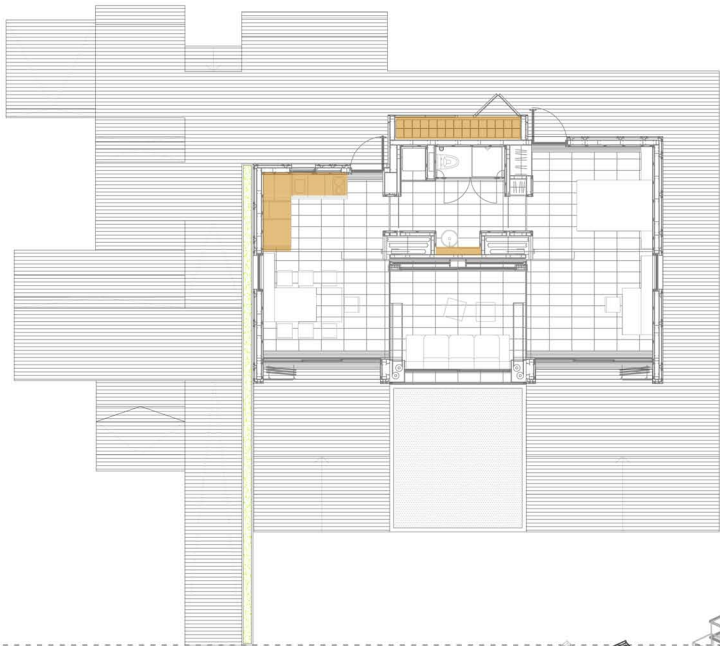

CROSS SECTION

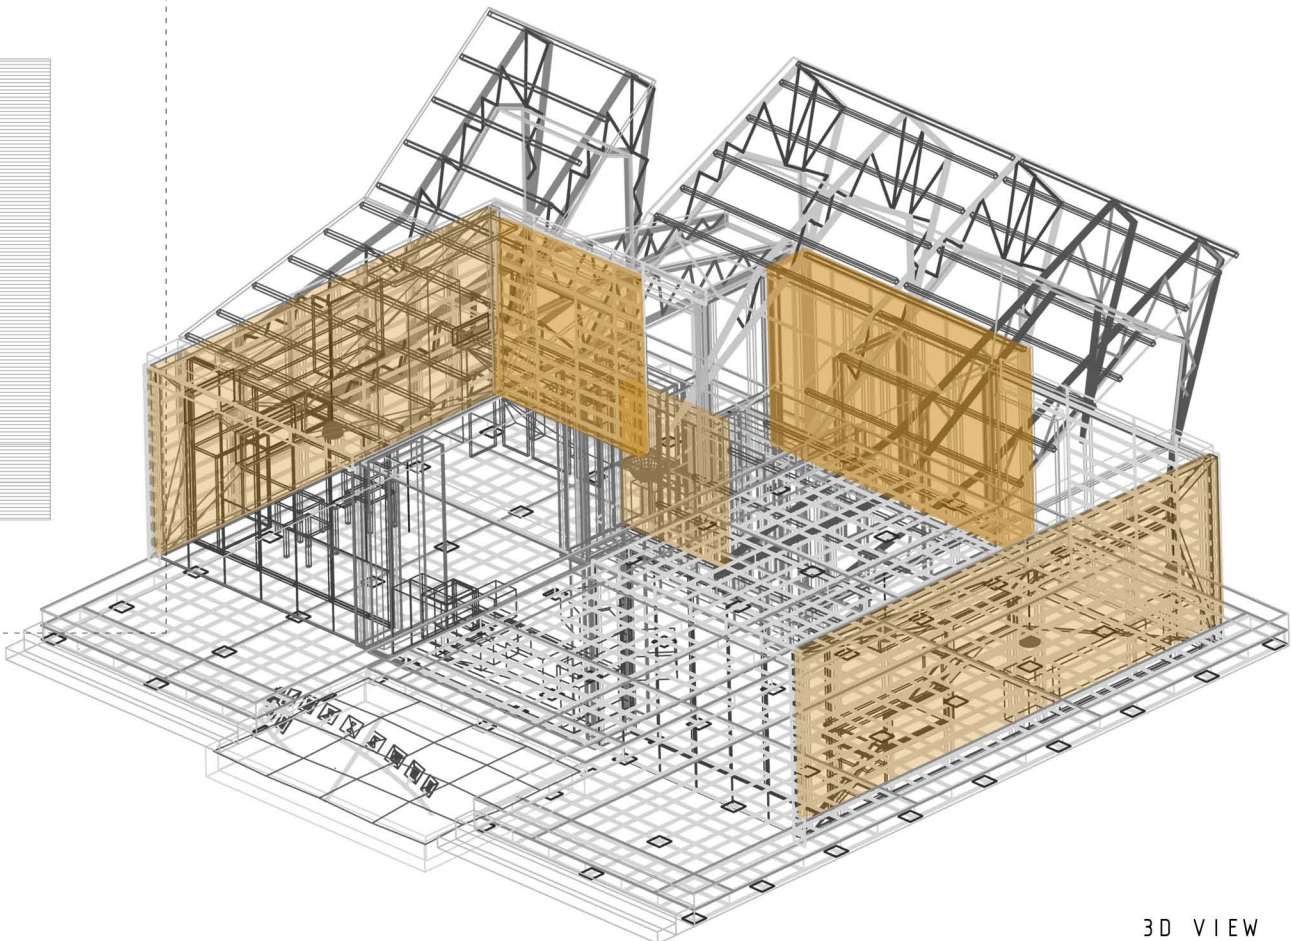

3D VIEW

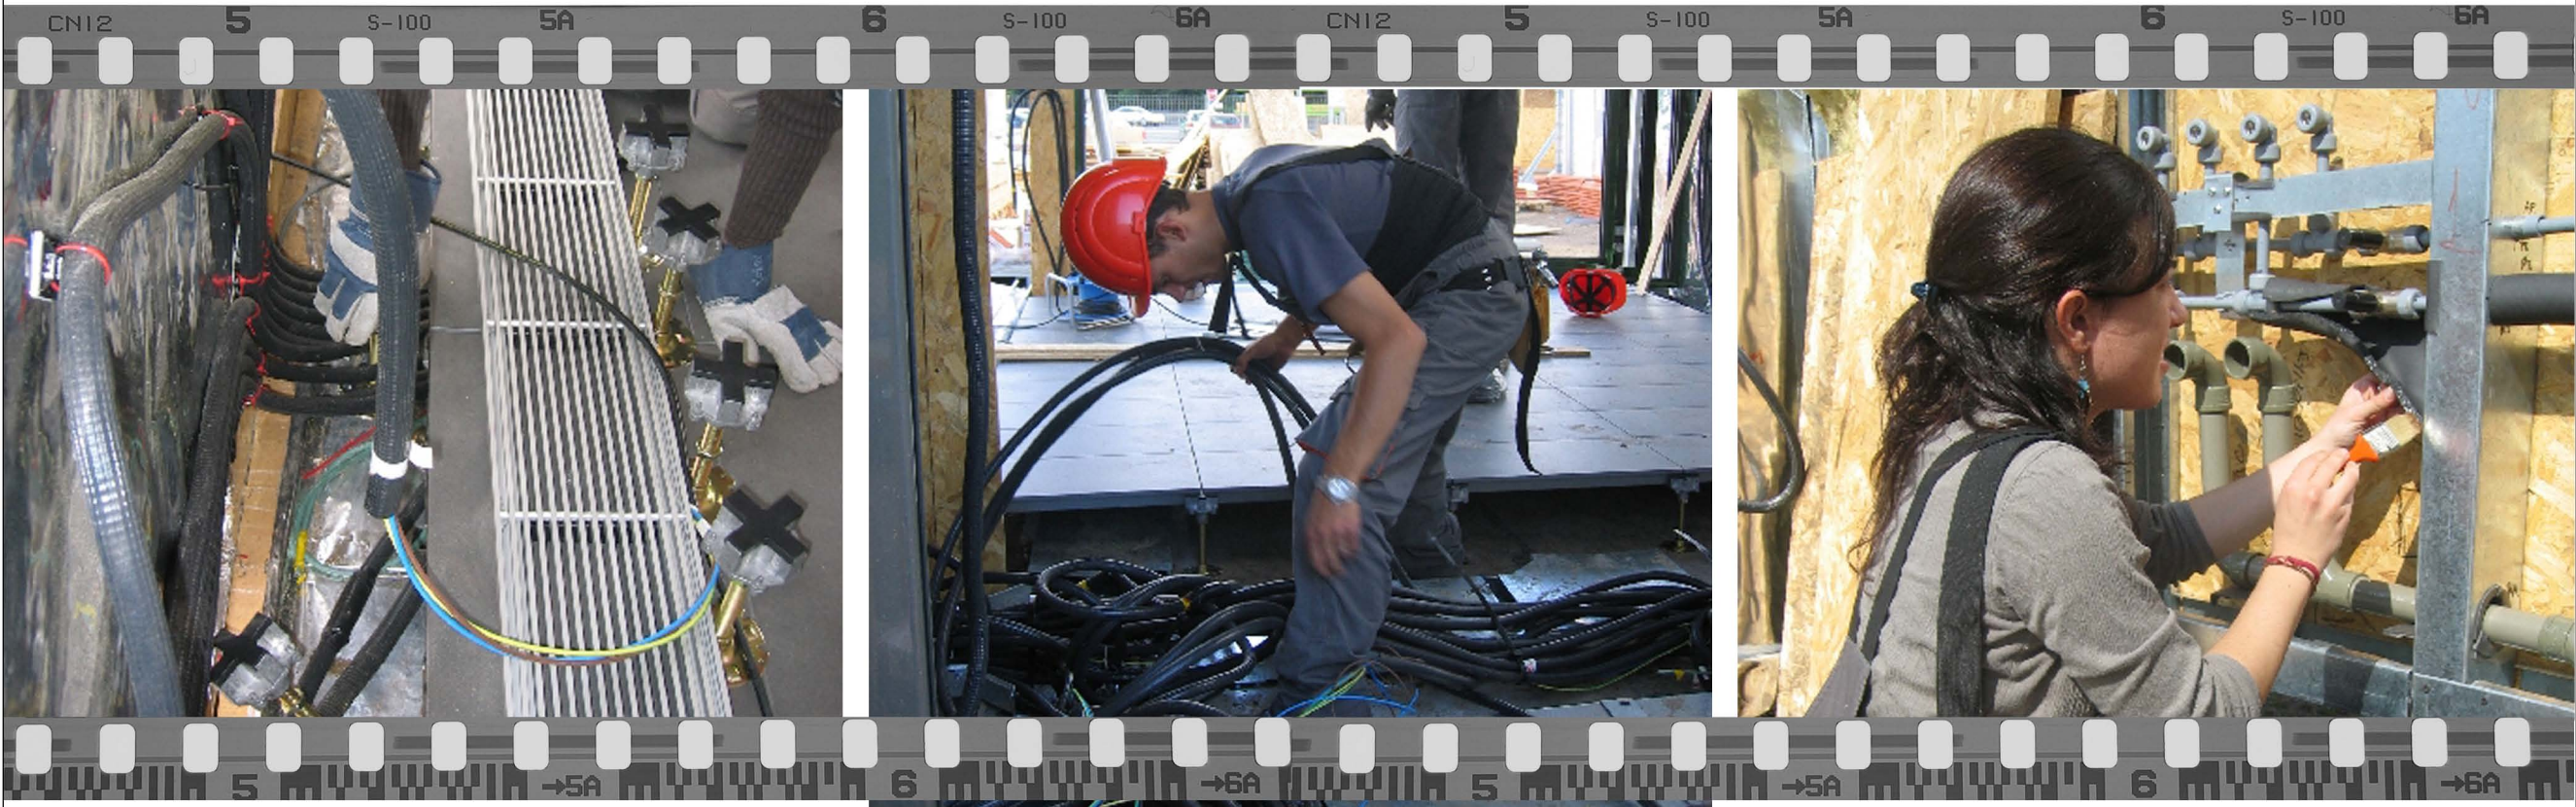


AD-59

DATE: 08.04.2005



SCALE\_1:200

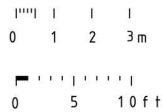

IVÁN ALCANTARILLA  
plan designer

CARLOS BERMEJO  
design coordinator

MIGUEL GOMEZ  
general coordinator

ALFONSO GARCIA-SANTOS  
construction manager

JAVIER NEILA  
architecture manager

ESTEFANIA CAAMAÑO  
general coordinator



unfolding under the sun  
Universidad Politécnica de Madrid (UPM)



08/10

AD-59

1:200

ASSEMBLY