


BC - 38

DATE: 2005.02.04



SCALE_1:40

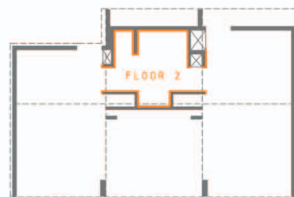

MONICA ALMAGRO
plan designer

CARLOS BERMEJO
design coordinator

MIGUEL GOMEZ
general coordinator

ALFONSO GARCIA-SANTOS
construction manager

JAVIER NEILA
architecture manager

ESTEFANIA CAAMAÑO
general coordinator



unfolding under the sun
Universidad Politécnica de Madrid (UPM)

04/07

BC - 38

1:40

FRAMING: BATHROOM