
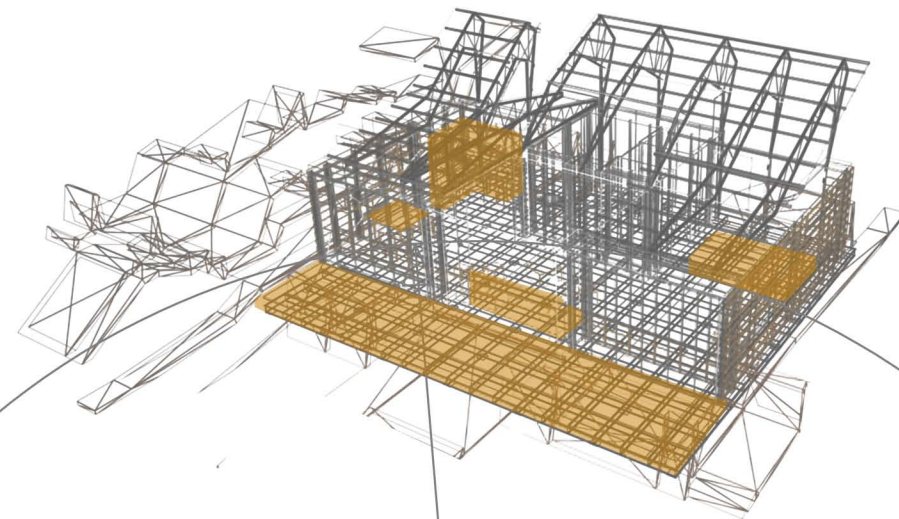


20 mt.

DAY 3


SOLAR GREENHOUSES
MOVABLE WALLS
SLIDING DOORS

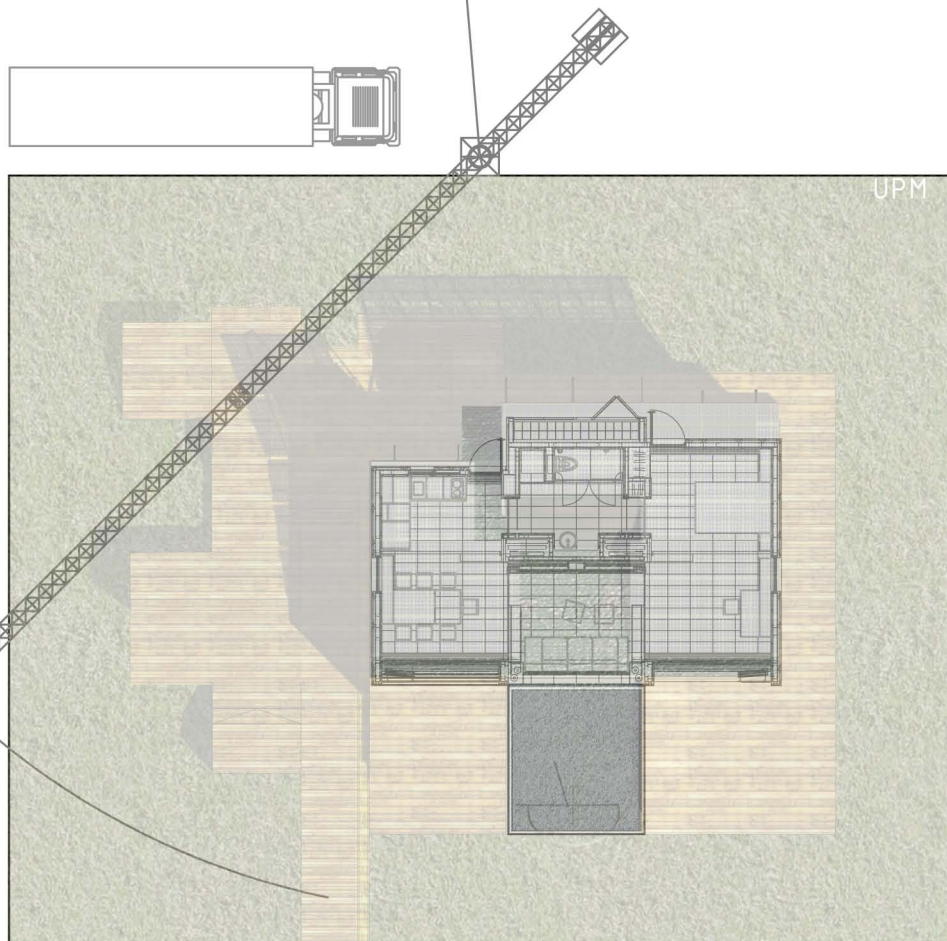

20 mt.

DAY 4

FURNITURE
DECKS
INTERIOR FINISHES

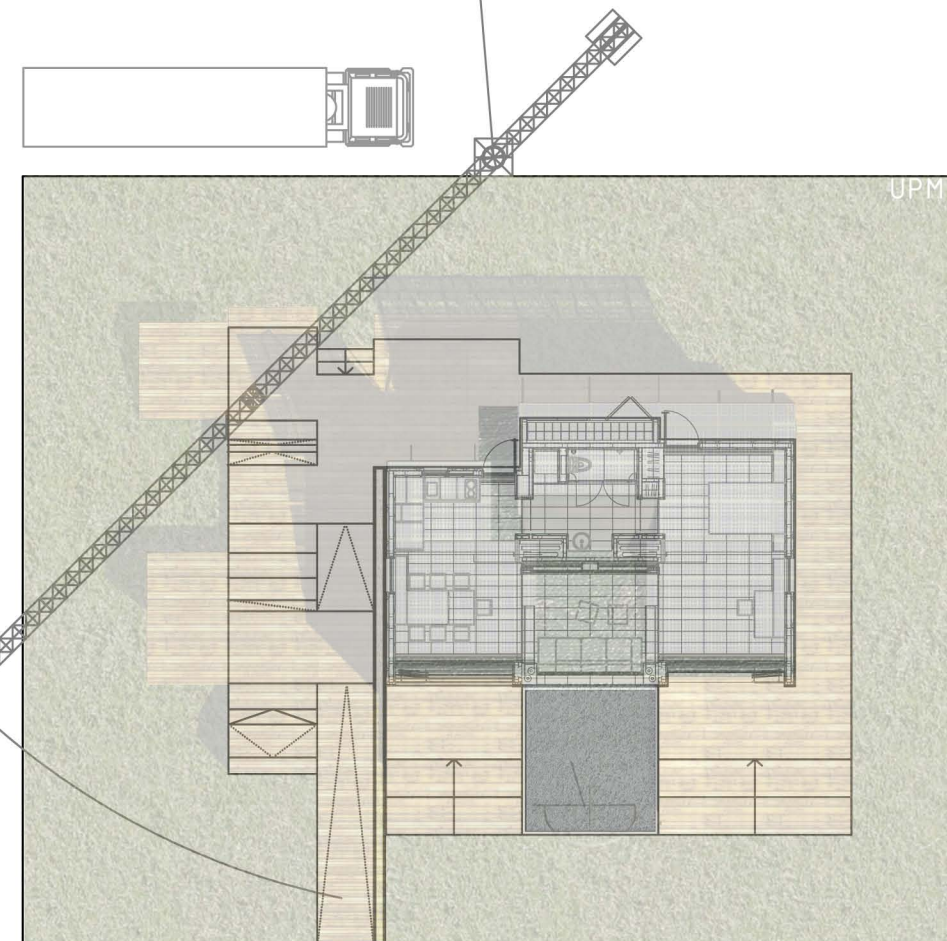

S0-62

DATE: 08.04.2005



02 / 03

S0 - 62

SCALE_1:200

0 1 2 3m

0 5 10ft

1:200

COORDINATORS SUPERVISORS DECATHLETES

IVÁN ALCANTARILLA
plan designer

CARLOS BERMEJO
design coordinator

MIGUEL GOMEZ
general coordinator

ALFONSO GARCIA-SANTOS
construction manager

JAVIER NEILA
architecture manager

ESTEFANIA CAAMAÑO
general coordinator

SITE OPERATIONS



unfolding under the sun
Universidad Politécnica de Madrid (UPM)