




[1] NO DIVISION

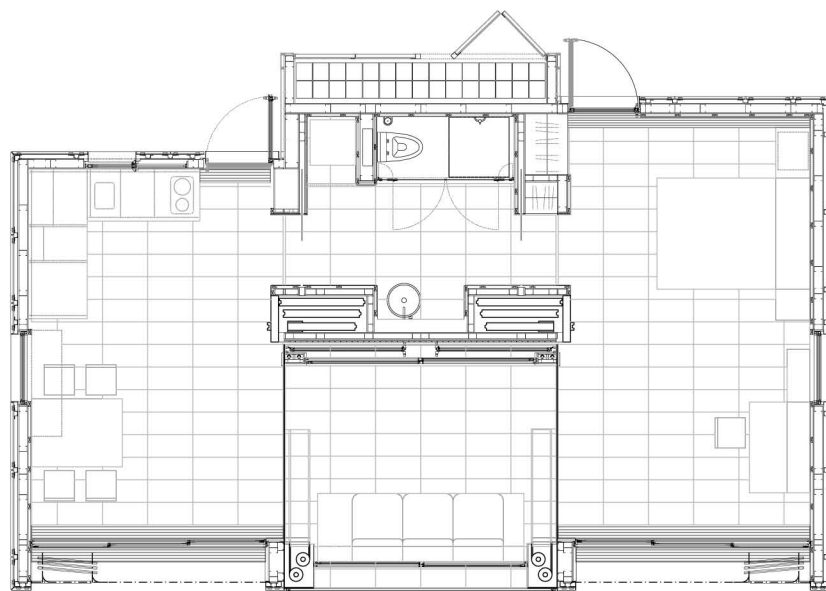

[2] NORTH-SOUTH DIVISION

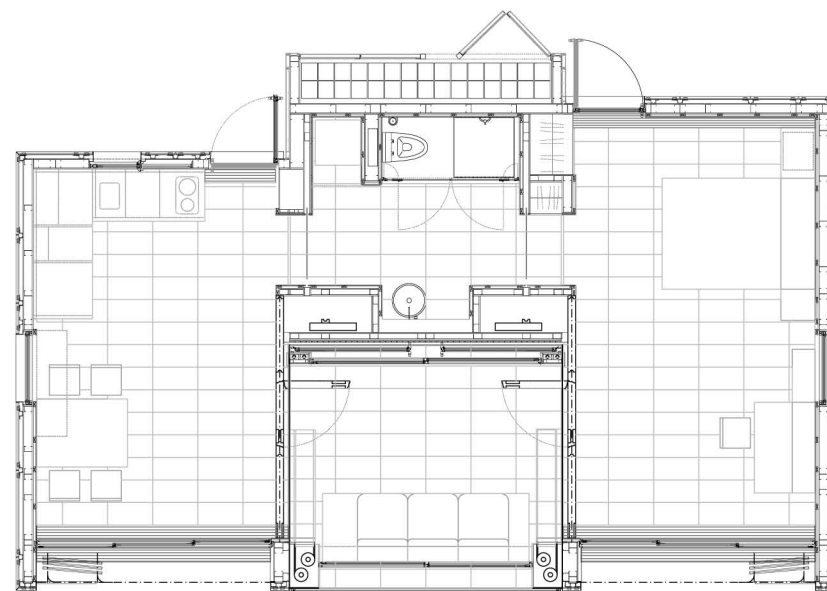

[3] EAST-WEST DIVISION

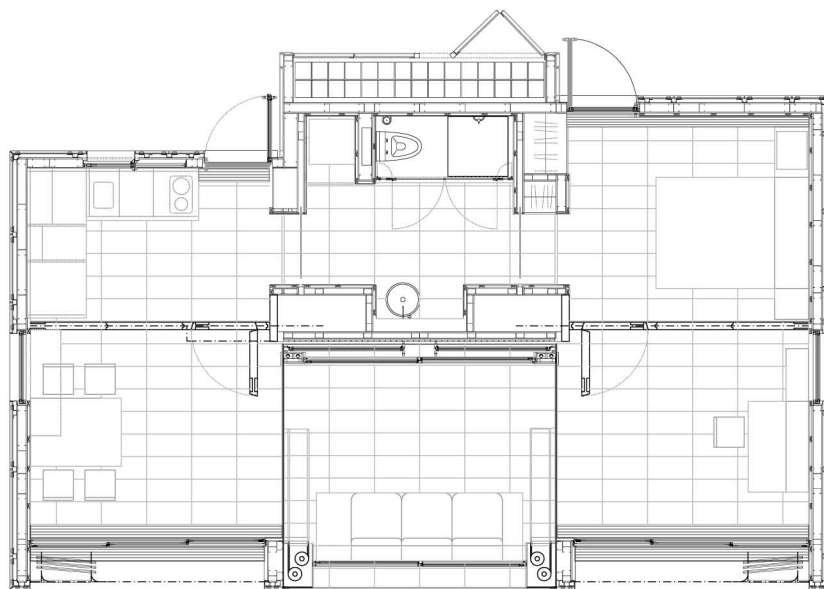

[1] NO DIVISION

BEDROOM + OFFICE + LOUNGE + DINING ROOM + KITCHEN + BATHROOM = 50.03m²

[2] NORTH-SOUTH DIVISION

KITCHEN + BATHROOM + BEDROOM = 21.95m²

LOUNGE + DINING ROOM + OFFICE = 28.08m²

[3] EAST-WEST DIVISION

KITCHEN + DINING ROOM = 16.01m²

LOUNGE = 10.07m²

BEDROOM + OFFICE = 18.46m²

BATHROOM = 5.91m²



A - 08


DATE: 08.04.2005



01/02

A - 08

SCALE_1:100

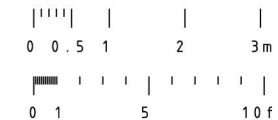

1:100

COORDINATORS SUPERVISORS DECATHLETES

RAFAEL PALOMARES
plan designer

CARLOS BERMEJO
design coordinator

MIGUEL GOMEZ
general coordinator

ALFONSO GARCIA-SANTOS
construction manager

JAVIER NEILA
architecture manager

ESTEFANIA CAAMAÑO
general coordinator

LAYOUTS: FOLDED POSITION



unfolding under the sun
Universidad Politécnica de Madrid (UPM)