


- SYMBOLS
- M MASTER NODE
 - N NODE
 - CABLE
 - RACEWAYS



E - 53

DATE: 08.04.2005

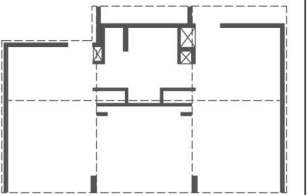

01/02

E - 53

SCALE_1:40



1:40

COORDINATORS SUPERVISORS DECATHLETES

ALVARO GUTIERREZ
plan designer

RAFAEL PALOMARES
graphic designer

MIGUEL GOMEZ
general coordinator



ANTONIO VILLANUEVA
IDOM industrial engineer

ALFONSO GARCIA-SANTOS
construction manager

JAVIER NEILA
architecture manager

ESTEFANIA CAAMAÑO
general coordinator

AUTOMATED CONTROL SYSTEM



Universidad Politécnica de Madrid (UPM)