

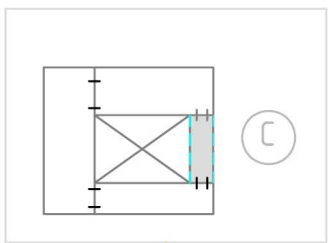


AREA 2 OSB FLAT ROOF PANELS (BATHROOM CEILING LAYOUT)


OSB FLAT ROOF PANELS (B)

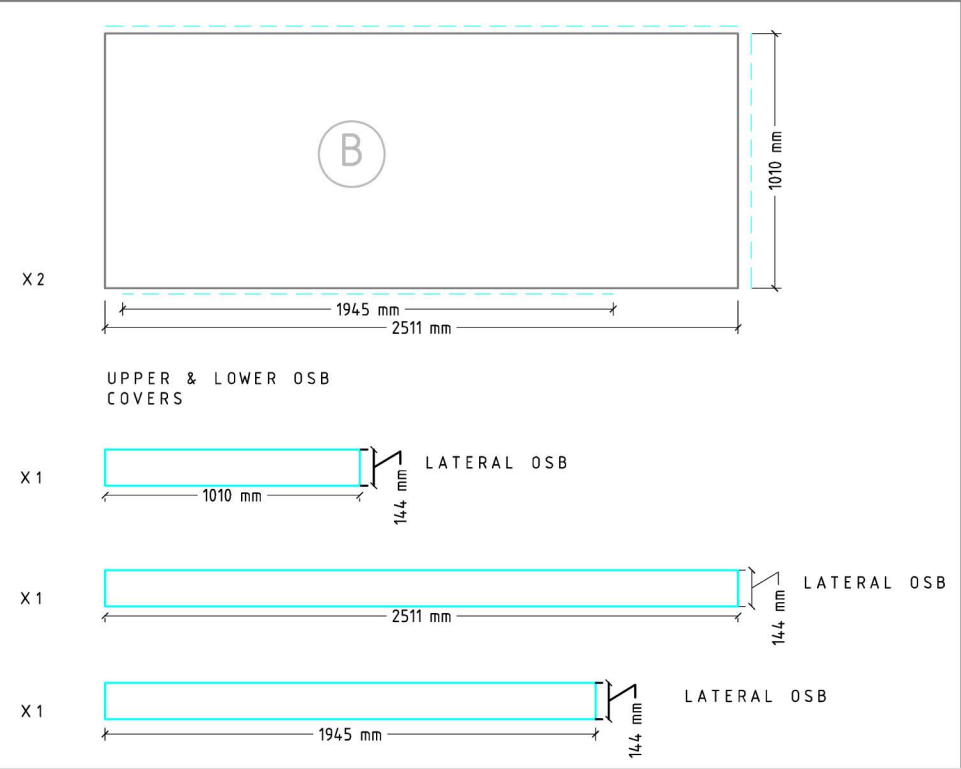


OSB FLAT ROOF PANELS (C)

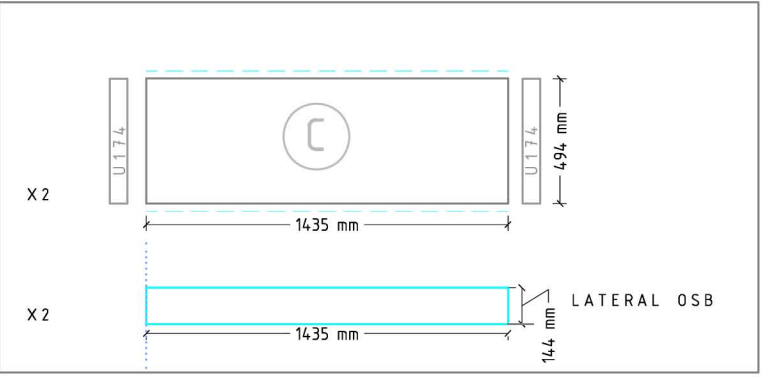



OSB FLAT ROOF PANELS (D)

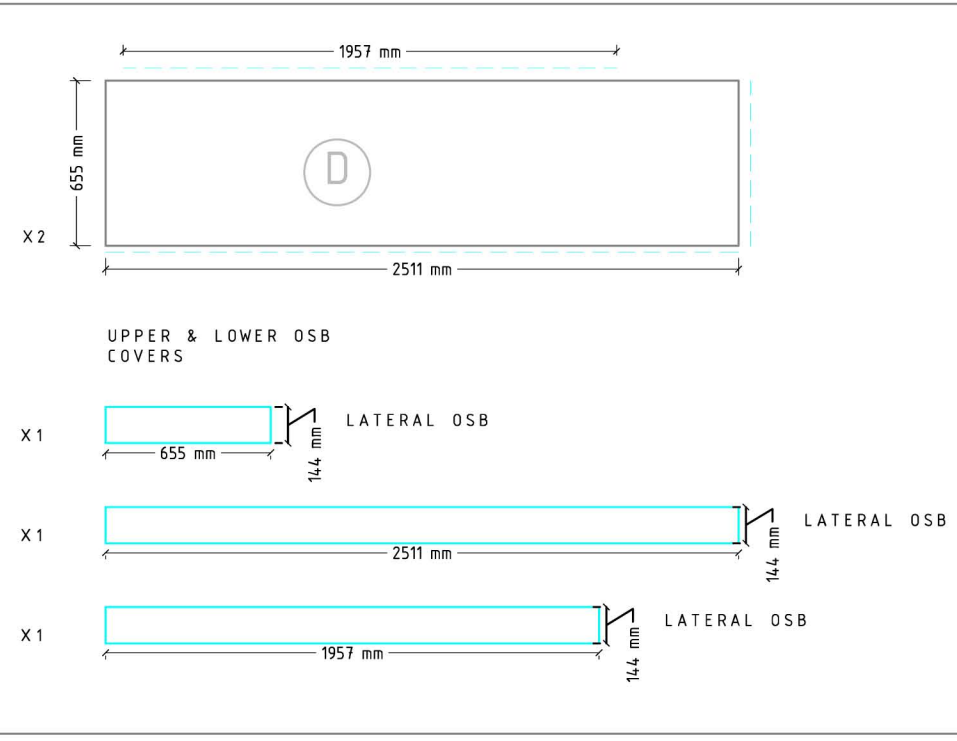

OSB FLAT ROOF PANELS (A)

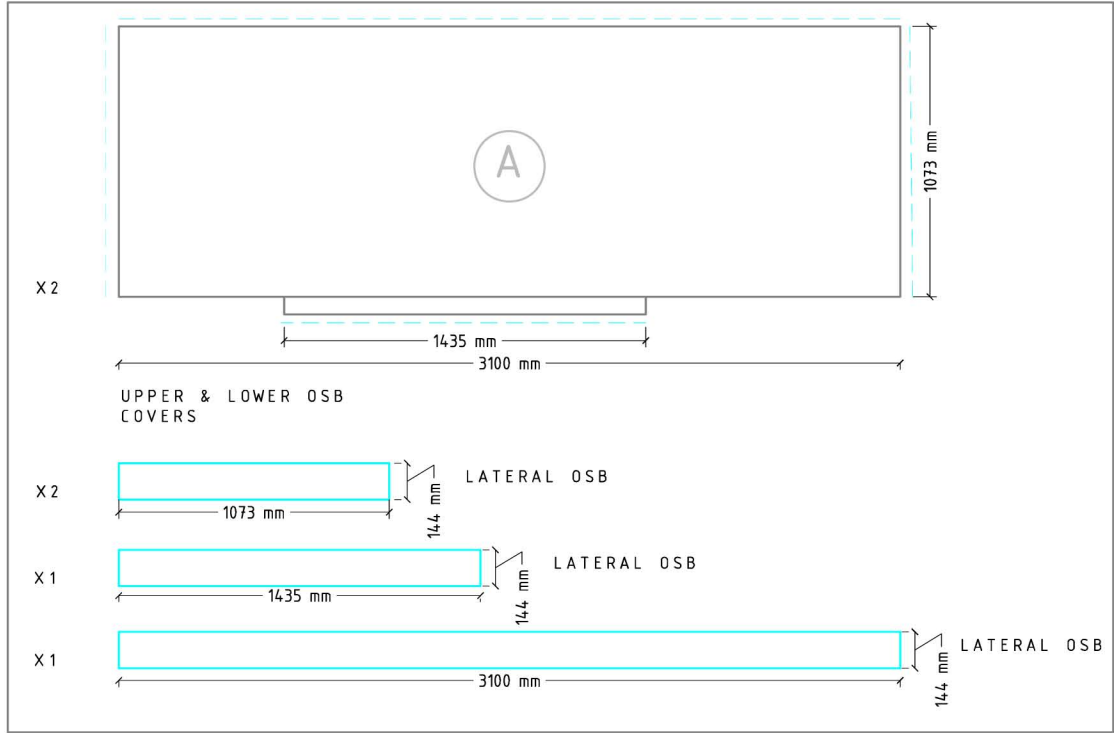


CEILING ROOF
FLAT ROOF

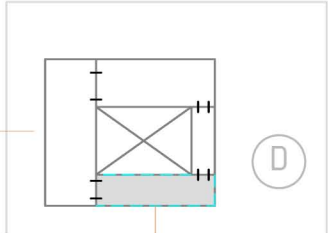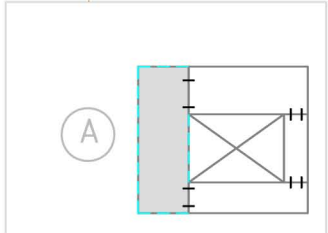

S - 22


DATE: 08.04.2005

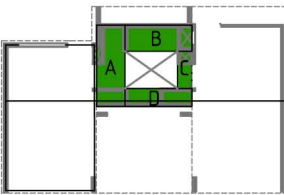

09/10

S - 22

SCALE_1:30

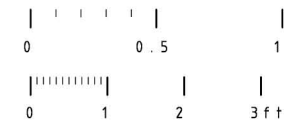

1:30

LETICIA RO-BER
plan designer
CARLOS BERMEJO
design coordinator
MIGUEL GOMEZ
general coordinator

JOE WORCESTER
professional engineer

ALFONSO GARCÍA-SANTOS
construction manager

JAVIER NEILA
architecture manager

ESTEFANÍA CAAMAÑO
general coordinator

OSB PANELS: ROOF LAYOUT



unfolding under the sun
Universidad Politécnica de Madrid (UPM)