

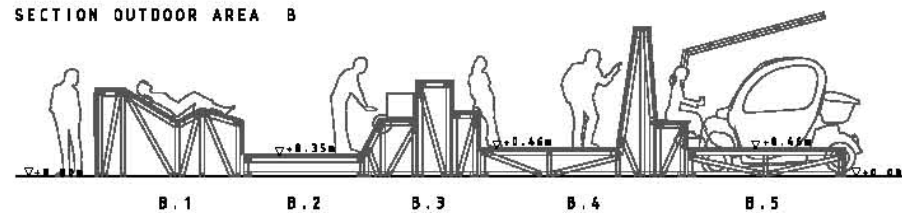



SECTION OUTDOOR AREA B.1

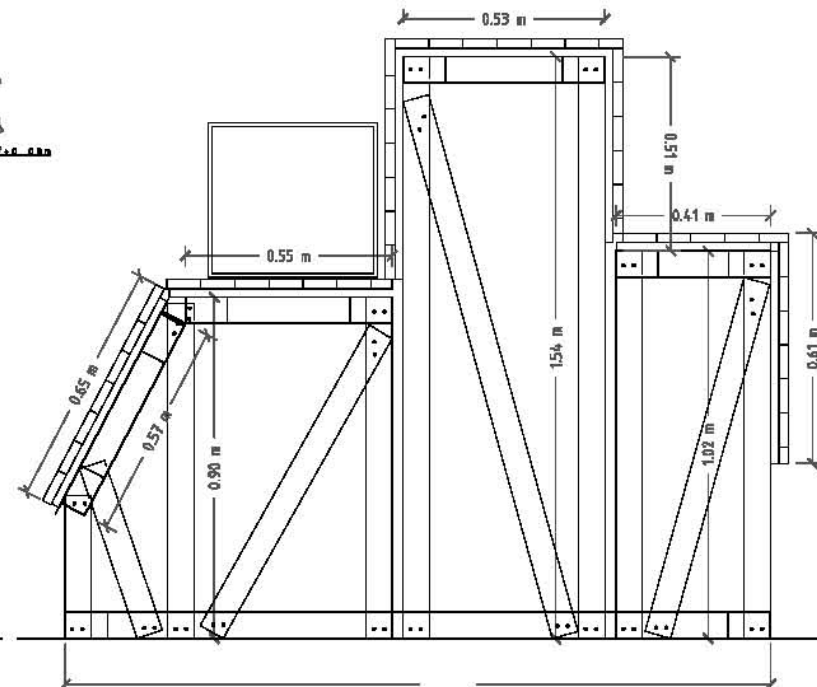


SECTION OUTDOOR AREA B.2

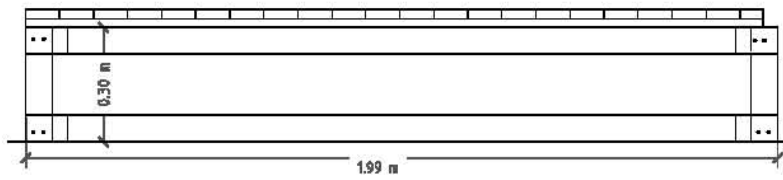


SECTION OUTDOOR AREA B.3

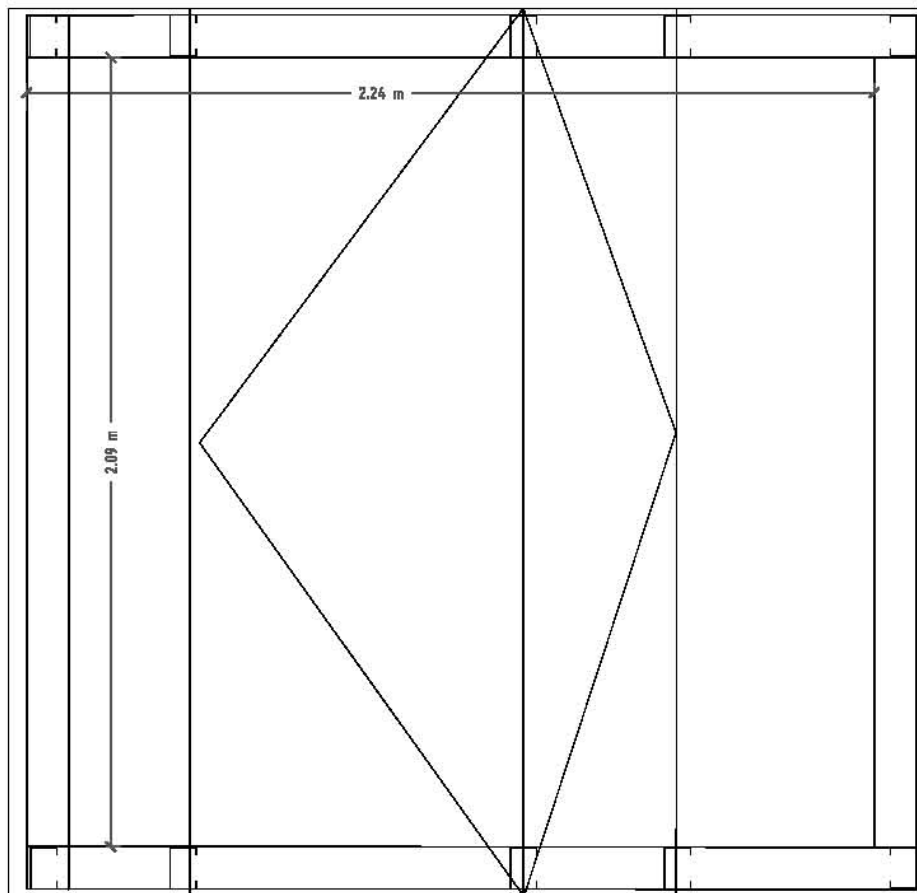

TOP OUTDOOR AREA B.1

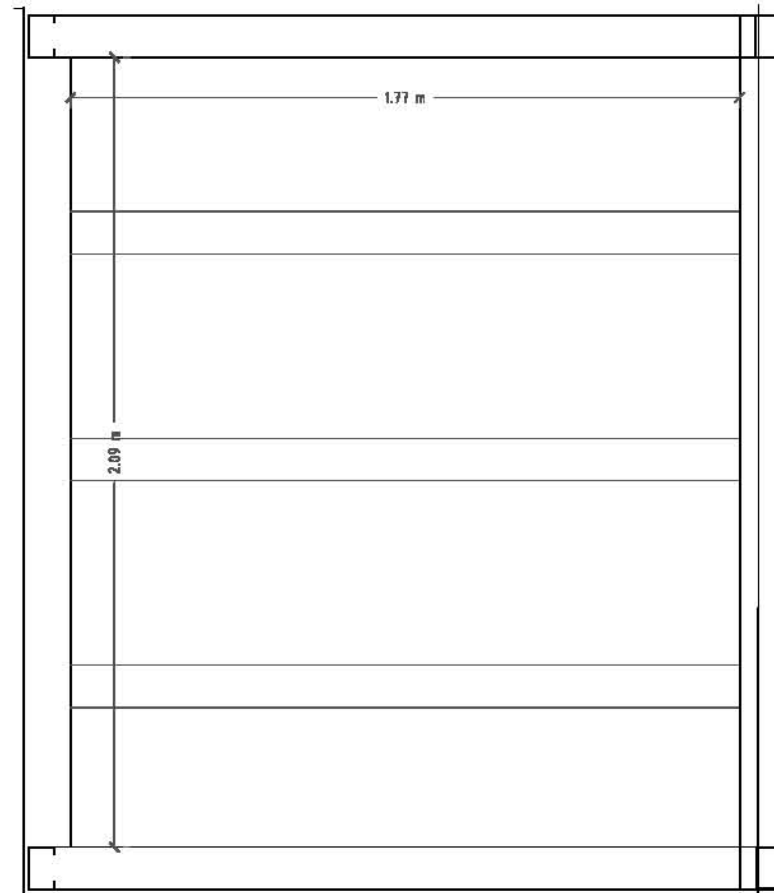

TOP OUTDOOR AREA B.2

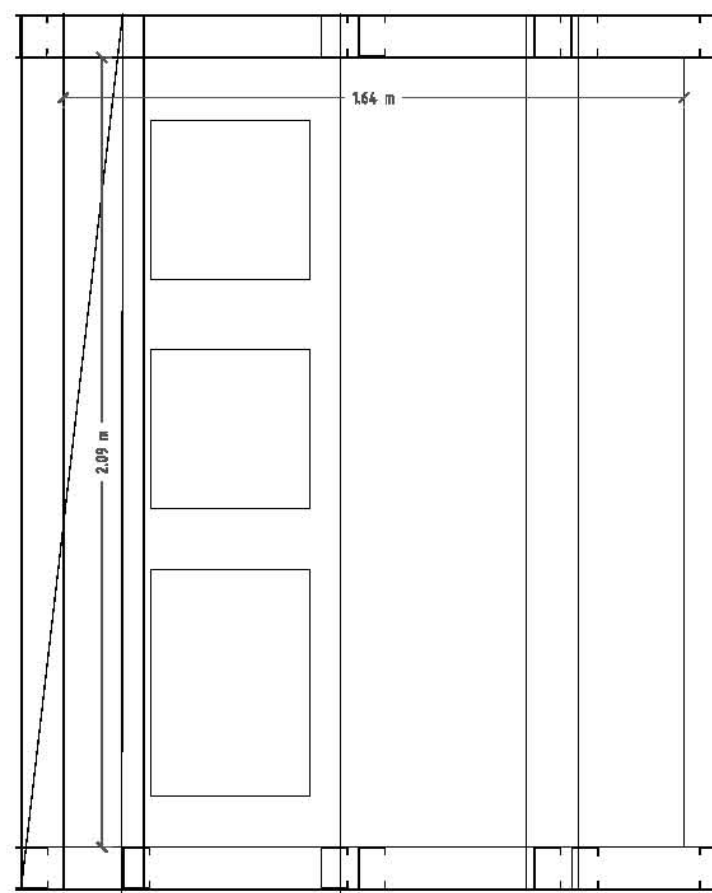


TOP OUTDOOR AREA B.3



BC-50

DATE: 08.04.2005

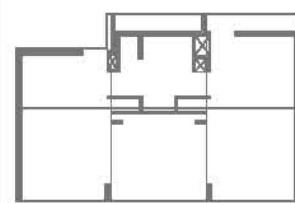

SCALE_1:20



MERCEDES PEÑA
ISABEL MONTANES
plan designer

CARLOS BERMEJO
design coordinator

MIGUEL GOMEZ
general coordinator

JOE WORCESTER
professional engineer

ALFONSO GARCIA-SANTOS
construction manager

JAVIER NEILA
architecture manager

ESTEFANIA CAAMAÑO
general coordinator

02/7

BC-50

1:20

OUTDOORS AREAS



unfolding under the sun
Universidad Politécnica de Madrid (UPM)