



60 ALUMINUM RECTANGULAR FRAMES of (648X1287mm.)  
The section is 50.10.2 mm. and 40.10.2mm.

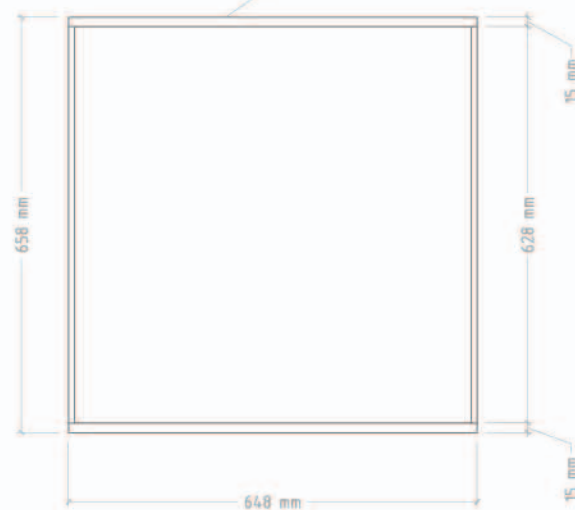

12 ALUMINUM SQUARE FRAMES of (648X658 mm.)  
The section is 50.10.2 mm. and 40.10.2mm.

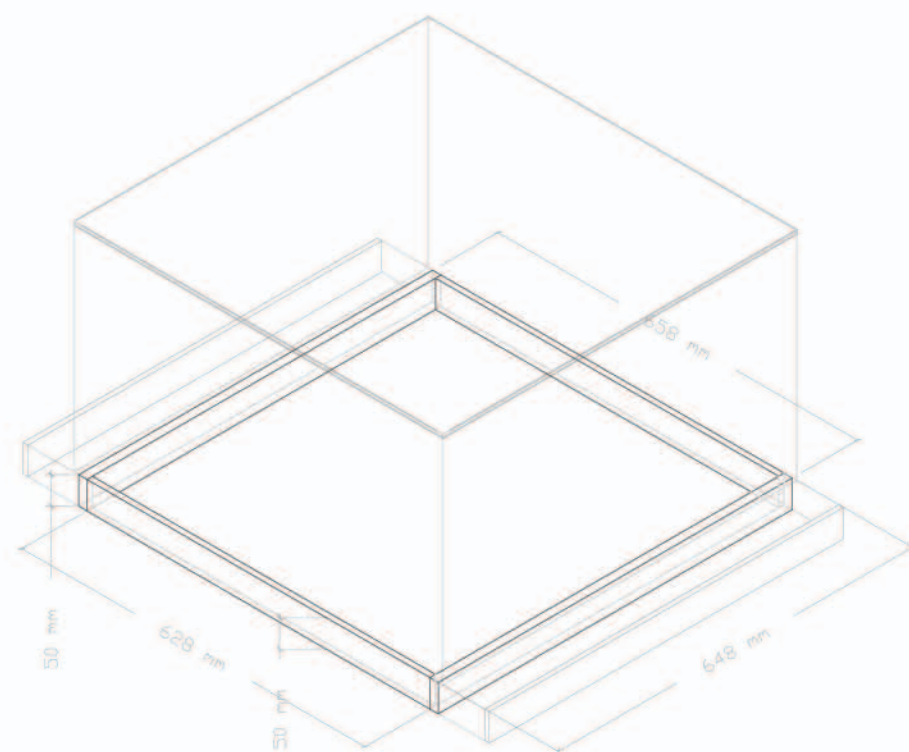