



OPENING NP1

- 1-Stainless steel plate 2mm
- 2-Stainless steel wire mesh
- 3-Stainless steel angle 2mm
- 4-Stainless steel tube 2mm

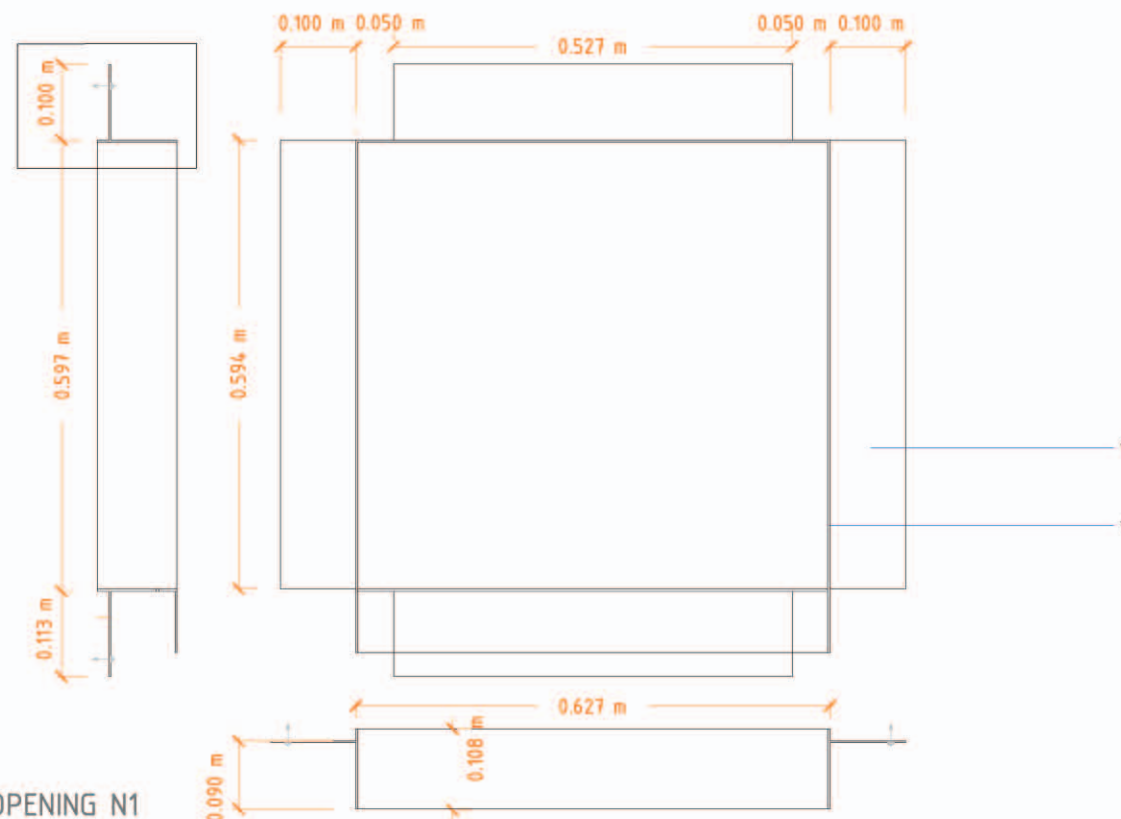

OPENING N1

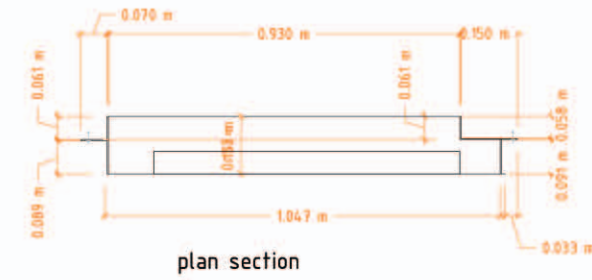


OPENING NP2



BC - 45

DATE: 08.04.2005

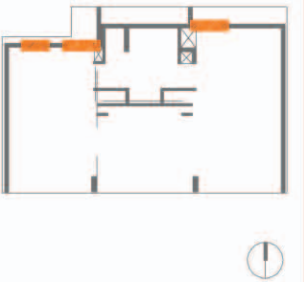

SEVERAL SCALES

SCALE_1: 10
SCALE_1: 20

COORDINATORS SUPERVISORS DECATHLETES

DANIEL CARDOSO
plan designer

CARLOS BERMEJO
design coordinator

MIGUEL GOMEZ
general coordinator

ALFONSO GARCIA-SANTOS
construction manager

JAVIER NEILA
architecture manager

ESTEFANIA CAAMAÑO
general coordinator



Intelling under the sun
Universidad Politécnica de Madrid (UPM)

02/05

BC - 45

SEVERAL SCALES

EXT.FINISH: OPENING FRAMING