


P - 55

DATE: 08.04.2005

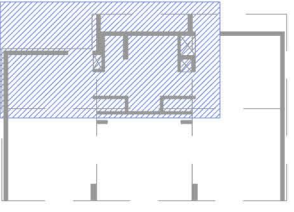

01/07

P - 55

NO_SCALE

SOFIA MELERO
GONZALO USED
plan designer

CARLOS BERMEJO
design coordinator

MIGUEL GOMEZ
general coordinator



ANTONIO VILLANUEVA
IDOM/professional supervisor

ALFONSO GARCIA-SANTOS
construction manager

JAVIER NEILA
architecture manager

ESTEFANIA CAAMAÑO
general coordinator



Universidad Politécnica de Madrid (UPM)

PLUMBING DRAWINGS. DIAGRAM.