






SECTION C

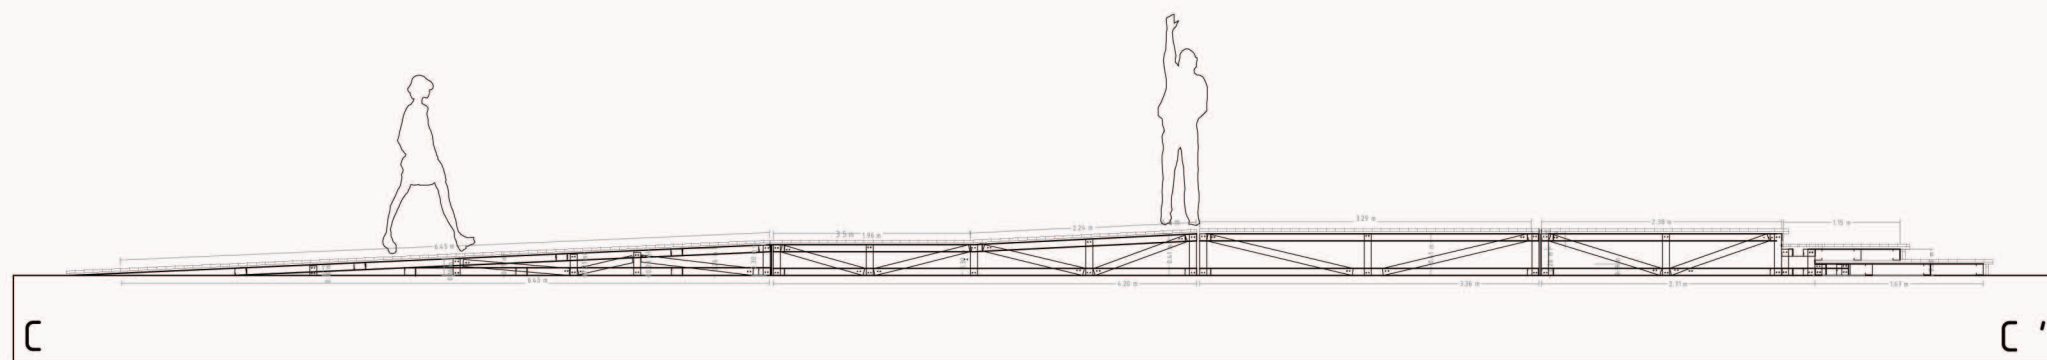

TOP C

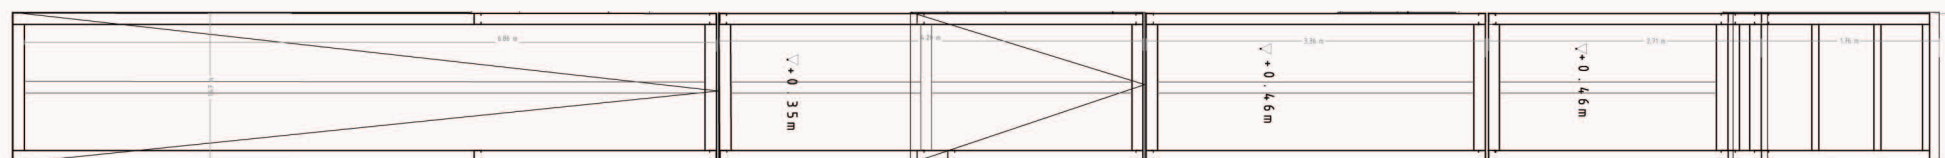

GENERAL PLAN

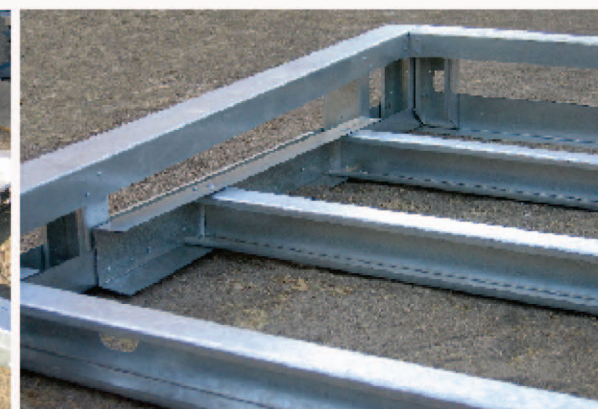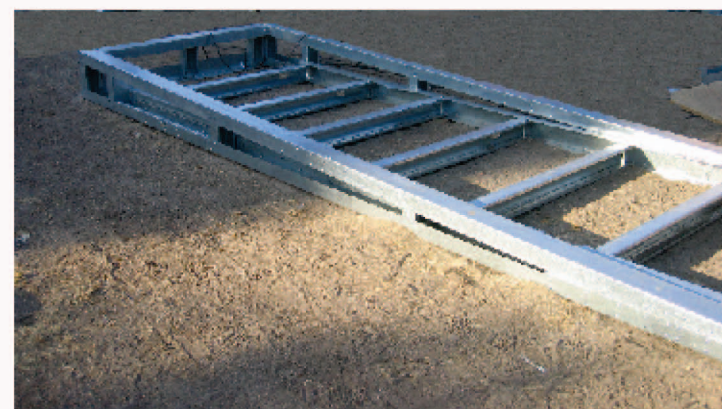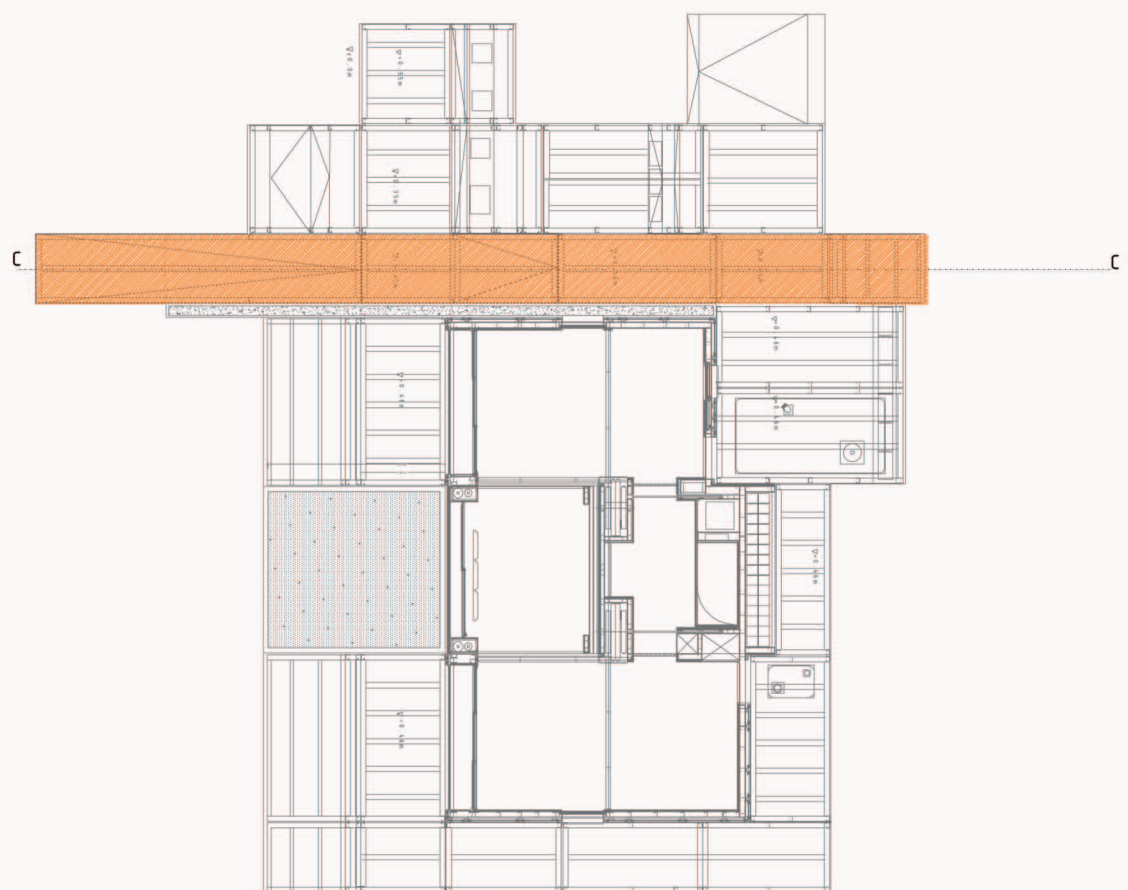

STRUCTURE _____ STEEL BUILT

WOODEN STRIPS


WOODEN SECONDARY STRUCTURE

CLIP

□ $\phi 110$


□ $\phi 112$

SCALE 1:5

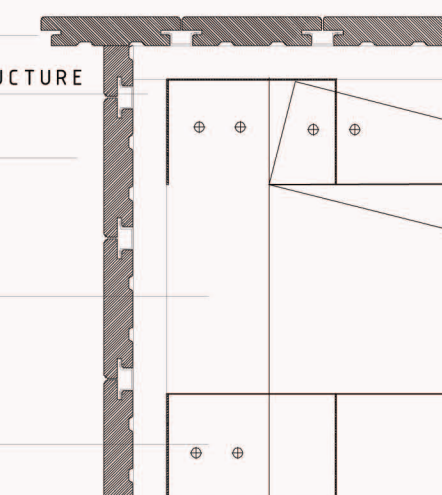

BC - 49

DATE: 08.04.2005

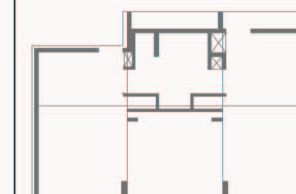

SEVERAL SCALES

SCALE_ 1:5

SCALE_ 1:50

COORDINATORS SUPERVISORS DE CATHLETES

MERCEDES PEÑA
ISABEL MONTANÉS
plan designer

CARLOS BERMEJO
design coordinator

MIGUEL GOMEZ
general coordinator

JOE WORCESTER
professional engineer

ALFONSO GARCIA-SANTOS
construction manager

JAVIER NEILA
architecture manager

ESTEFANIA CAAMAÑO
general coordinator

OUTDOOR AREAS



Unifolding under the sun
Universidad Politécnica de Madrid (UPM)