



DETAIL 1

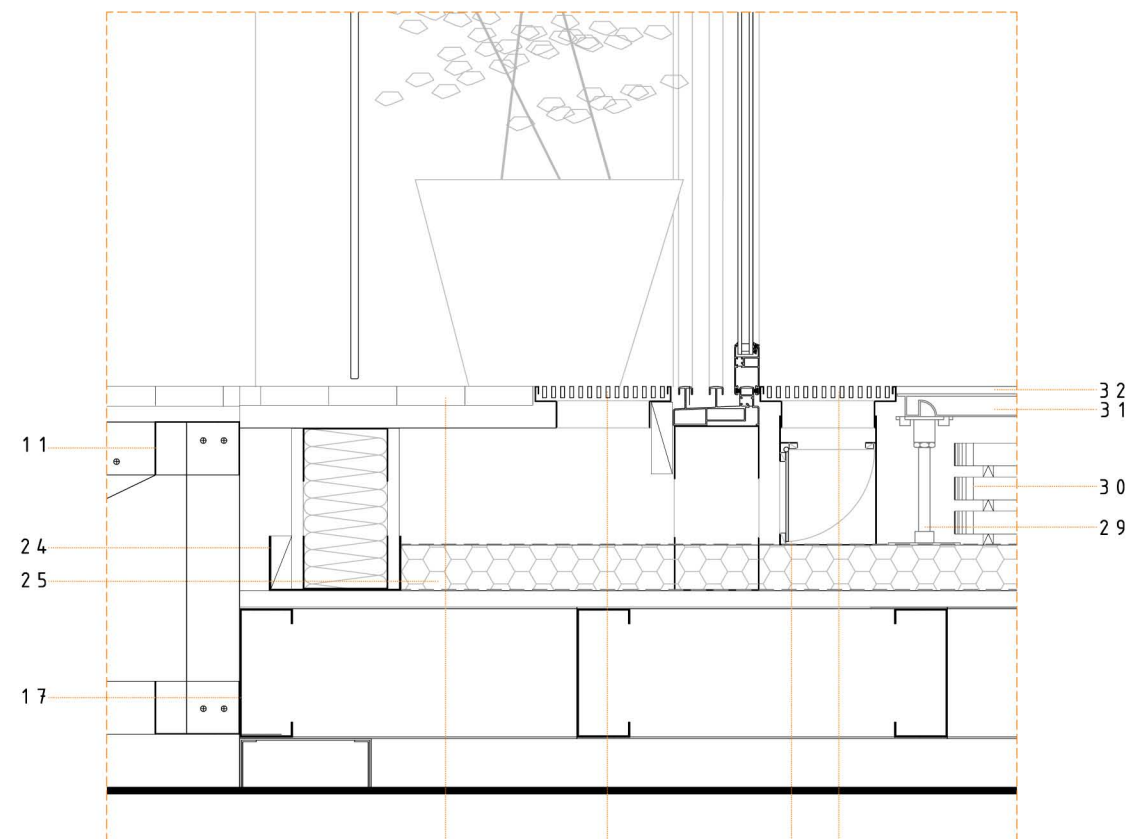

DETAIL 2

#### LEGEND


- 01. SOIL
- 02. PLANTER
- 03. REINFORCING WATERPROOFING
- 04. T-PLUS GALVANIZED-STEEL PLATE
- 05. CLAY TILE
- 06. FIXING CLIP
- 07. L-SHAPED STEEL PLATE
- 08. ALUMINUM SLIDING GLAZING TRACK
- 09. ALUMINUM GLAZING FRAME
- 10. ENHANCED PROTECTIVE GLASS (EPG)
- 11. 112x70x1mm U-SHAPED STEEL JOIST
- 12. 112x70x1mm C-SHAPED STEEL JOIST
- 13. 16mm-THICK OSB
- 14. 22mm-THICK OSB
- 15. PROTECTION AGAINST PUNCHING
- 16. (WATERPROOFING) PVC
- 17. 170x70x20x2mm C-SHAPED STEEL JOIST
- 18. 100mm-THICK GLASS WOOL
- 19. TRUSS
- 20. PVC SLIDING SASH
- 21. PVC GLAZING FRAME
- 22. DOUBLE GLAZING
- 23. ALMOND SHELL PANEL
- 24. 170x70x2mm U-SHAPED STEEL JOIST
- 25. 60mm-THICK WOOD-FIBER INSULATION
- 26. WOODEN DECKING
- 27. ALUMINUM VENTILATION GRATE
- 28. STEEL TRAPGATE (AUTOMATED CONTROL SYSTEM)
- 29. FLOOR PLOT
- 30. CHANGE-OF-PHASE GEL CAPSULES
- 31. 600x600mm CAST IRON BASE
- 32. 600x300mm CERAMIC TILE

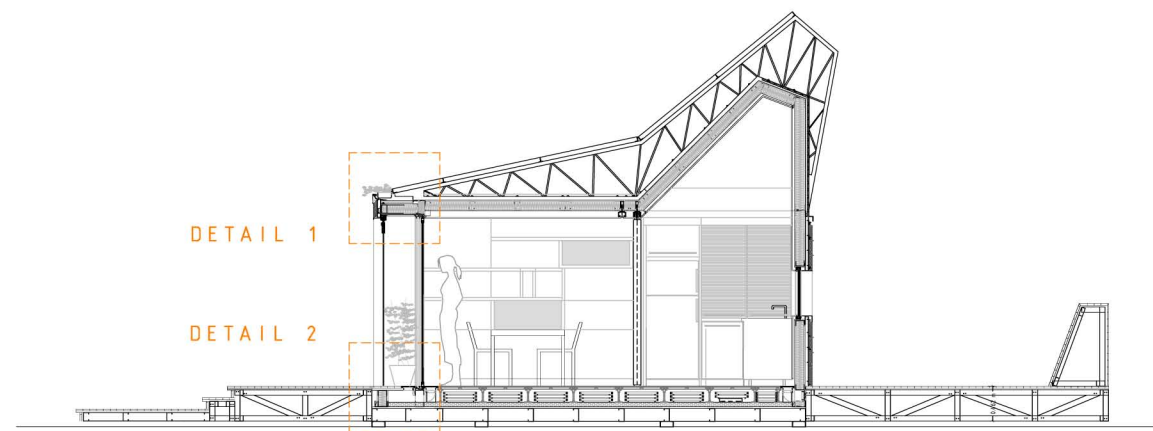


SCALE 1:100

BC - 34

DATE: 08.04.2005

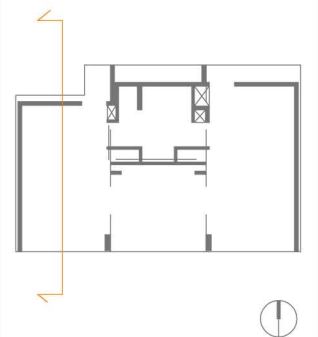

SCALE\_1:10

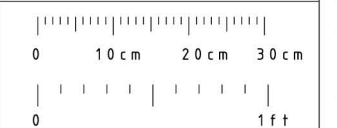

COORDINATORS SUPERVISORS DECATHLETES

CARLOTREZZO  
plan designer

CARLOS BERMEJO  
design coordinator

MIGUEL GOMEZ  
general coordinator

JOE WORCESTER  
professional engineer

ALFONSO GARCIA-SANTOS  
construction manager

JAVIER NEILA  
architecture manager

ESTEFANIA CAAMAÑO  
general coordinator

CONSTRUCTION DETAILS