

SIEMENS APPLIANCES.★

- a 0 6 WASHING MACHINE
WIG 1632 EU (A+,A,A).
Capacity: 6 Kg.
Dimensions: 85,2x60x59 cm.
- a 0 7 DRYER. WTXL 2402 EE
Capacity: 6 Kg.
Diemensions: 85x60x58 cm.

★More appliances in E-54.




"COMPAC" **gala**
DUAL DISCHARGE CISTERN
AND WALL SUPPORT.
[CATALOGUE 2004 PG.65]

SLIDING SILENT SYSTEM FOR GLASS DOORS
WITH A TOP HIDDEN RAIL.
THE PANEL IS MADE OF STADIT 4+4mm
TRANSLUCENT GLASS.

WHEELCHAIR-ACCESSIBLE ROUTE ALLOWS
WHEELCHAIRS TO TURN INSIDE THE BATHROOM.
THE SHOWER PLATE IS INTEGRATED INTO THE
FLOOR.

MIRRORED BUILT-IN CABINET.

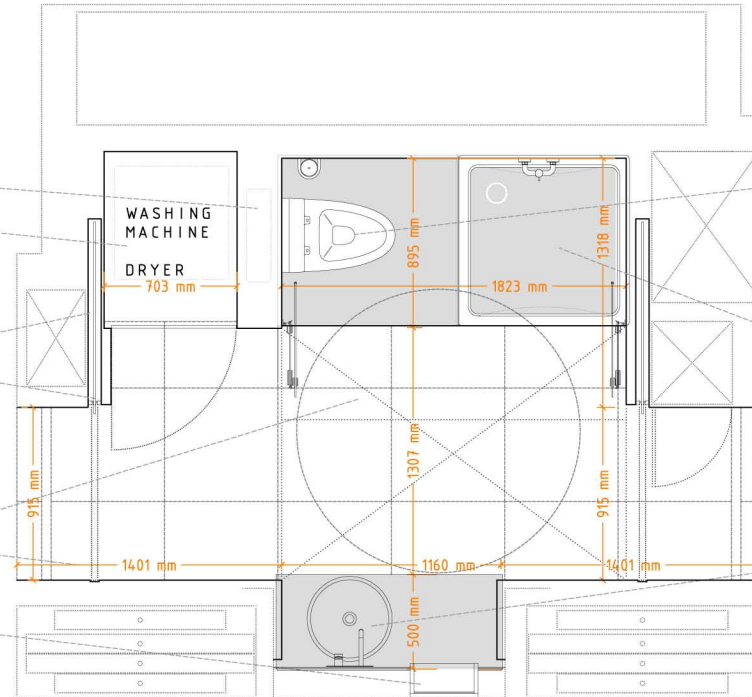


"ARQ." **gala**
WALL MOUNTED TOILET
MATERIALS: 00 WHITE
PORCELAIN.
[CATALOGUE 2004 PG.19]

"SIRTE" **gala**
ACRYLIC SHOWER TRAY
900x900 mm
[CATALOGUE 2004 PG.79]


"MODERN" **gala**
WASHBASIN. 450X450MM.
[CATALOGUE 2005].

BC - 4 2

DATE : 08.04.2005

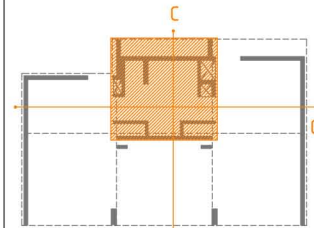

SCALE_1:40

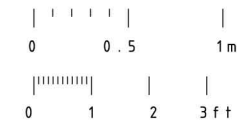

COORDINATORS SUPERVISORS DECATHLETES

SOFIA MELERO
GONZALO USED
plan designers

CARLOS BERMEJO
design coordinator

MIGUEL GOMEZ
general coordinator

COORDINATOR SUPERVISOR DECATHLETES

ALFONSO GARCIA-SANTOS
construction manager

JAVIER NEILA
architecture manager

ESTEFANIA CAAMAÑO
general coordinator

01/02

BC - 4 2

1:40

BATHROOM FURNITURE