


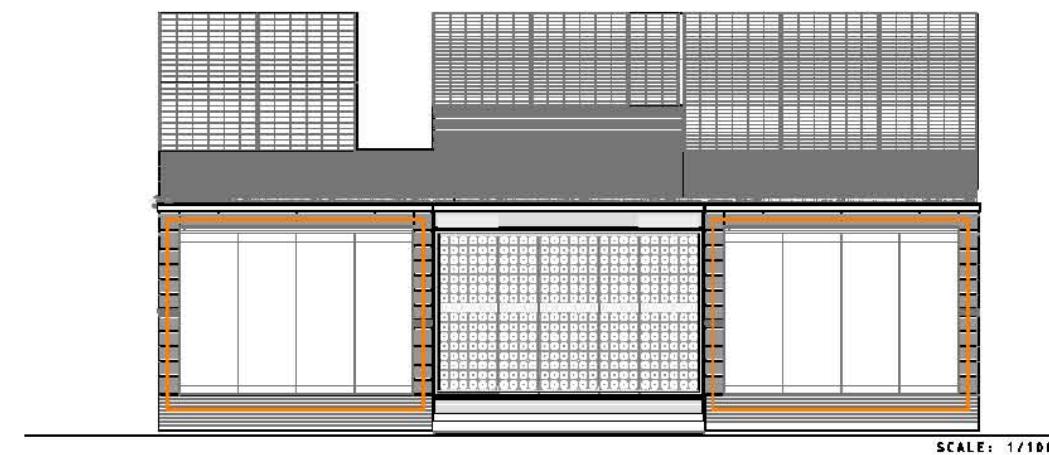
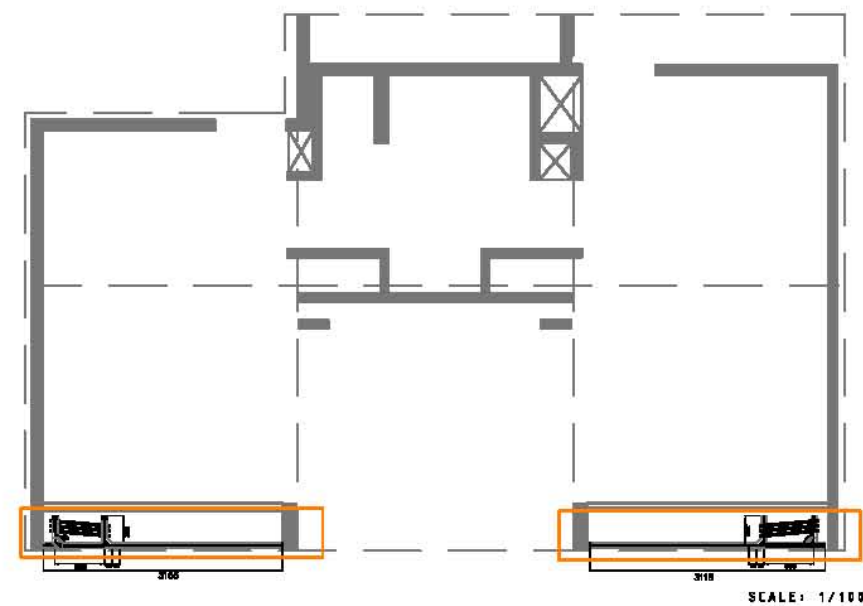


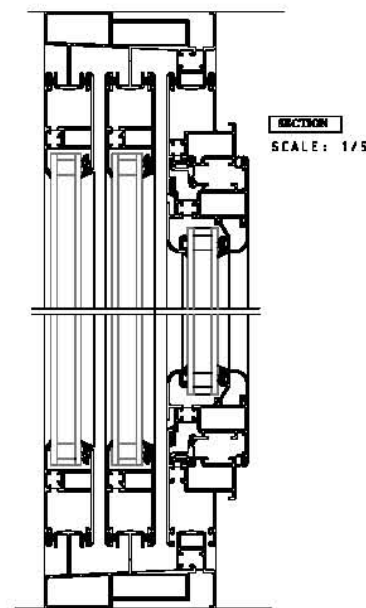



PICTURE S3

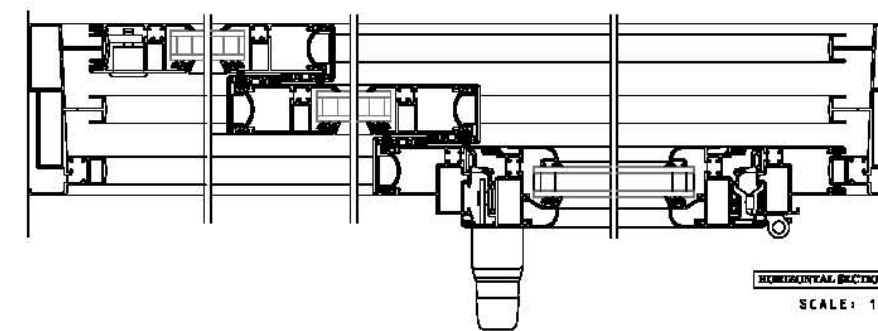

PICTURE S1

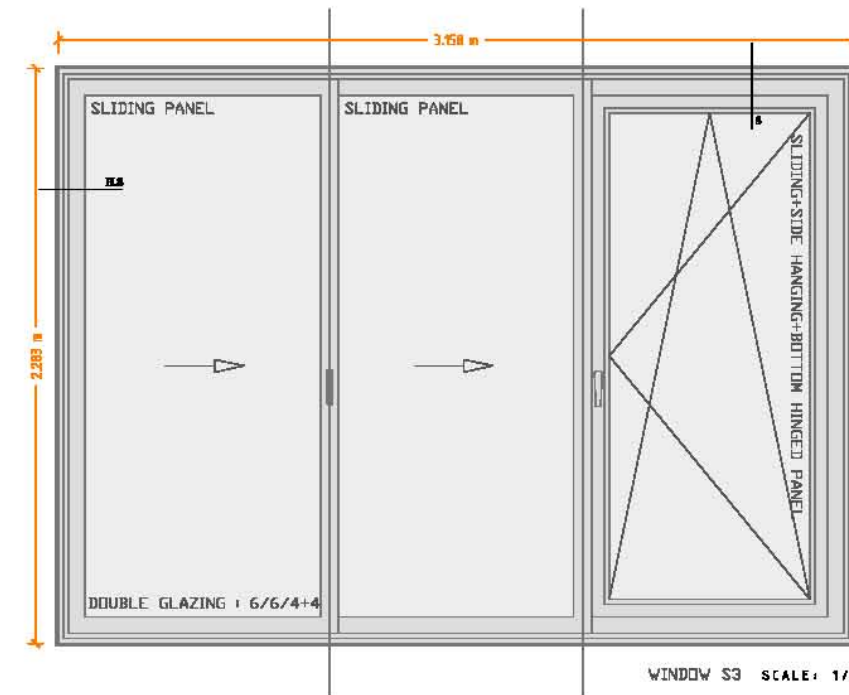

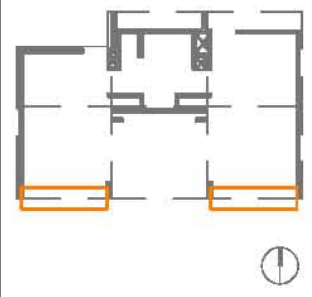		
<b>BC - 47</b> DATE: 08.04.2005		
		<b>BC - 47</b> 02/07
<b>SEVERAL SCALES</b> 1 : 100 1 : 20 1 : 5		<b>SEVERAL SCALES</b>
<b>COORDINATORS</b> ALFONSO GARCIA-SANTOS construction manager JAVIER NEILA architecture manager ESTEFANIA CAAMAÑO general coordinator		
<b>SUPERVISORS</b> JOSE LUIS PEREZ-GRILLO plan designer CARLOS BERMEJO design coordinator MIGUEL GOMEZ general coordinator		<b>GLAZING AND FRAMING: GREENHOUSES</b>
 unfolding under the sun Universidad Politécnica de Madrid (UPM)		