



GROUND FLOOR STRUCTURE DETAILS

Detail 1- Structural floor joint.

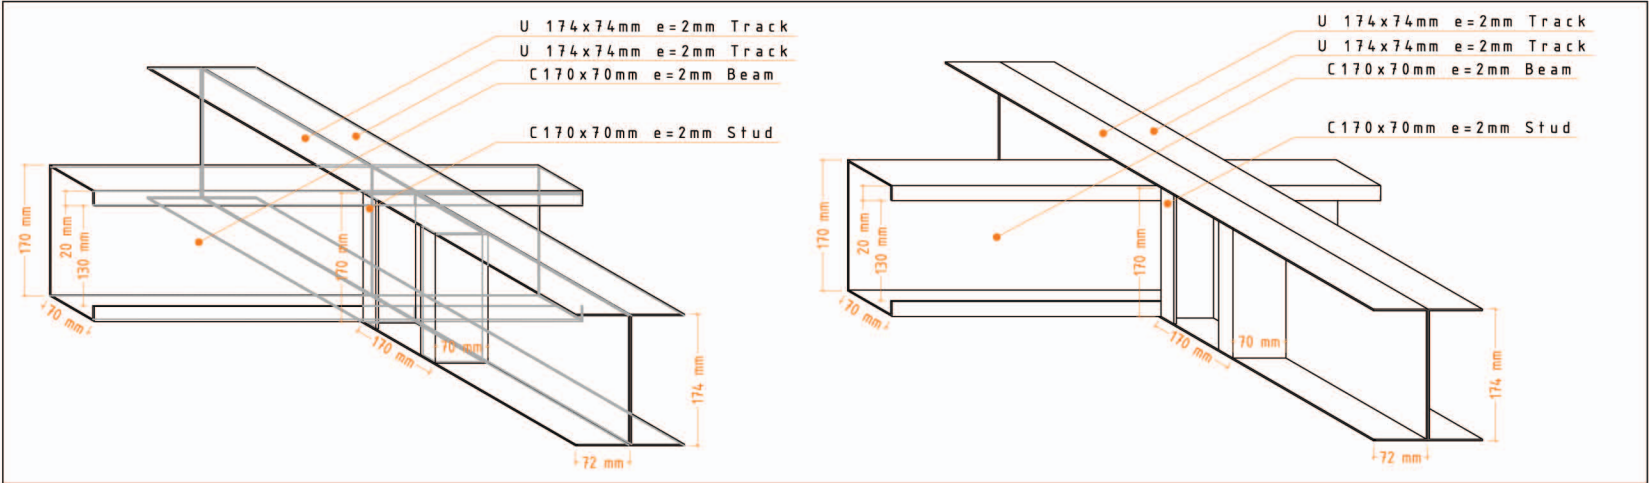


E: 1/10

Detail 2- structural floor edge.

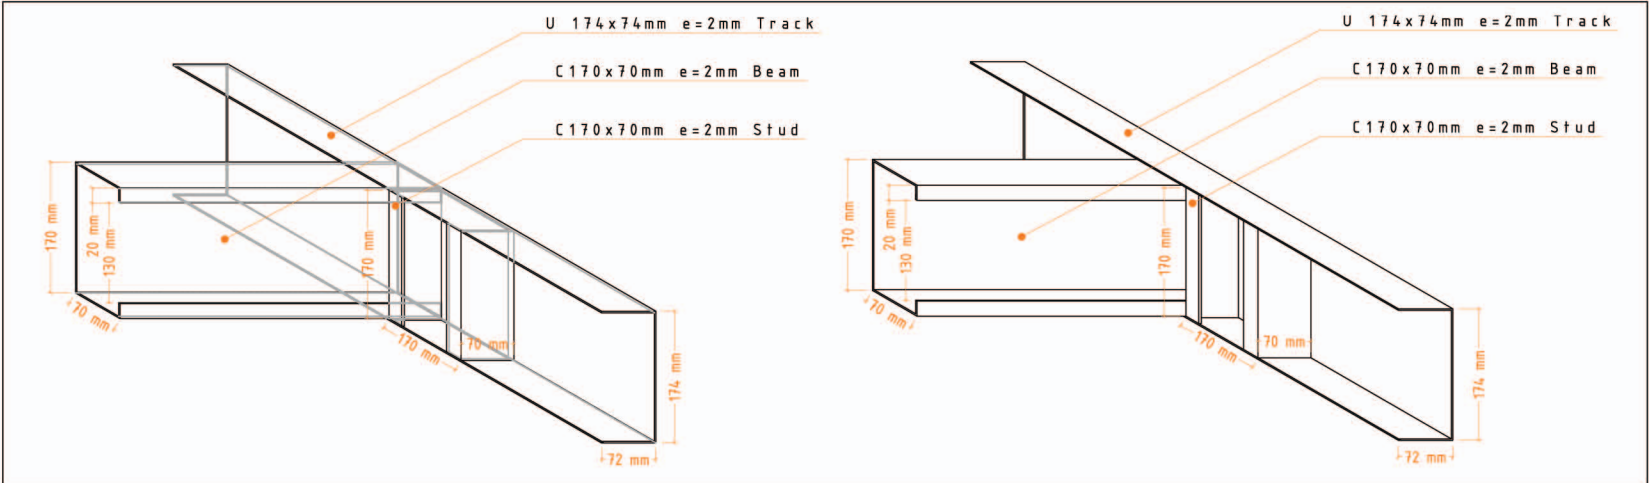


E: 1/10

Detail 3- Foundation piece.

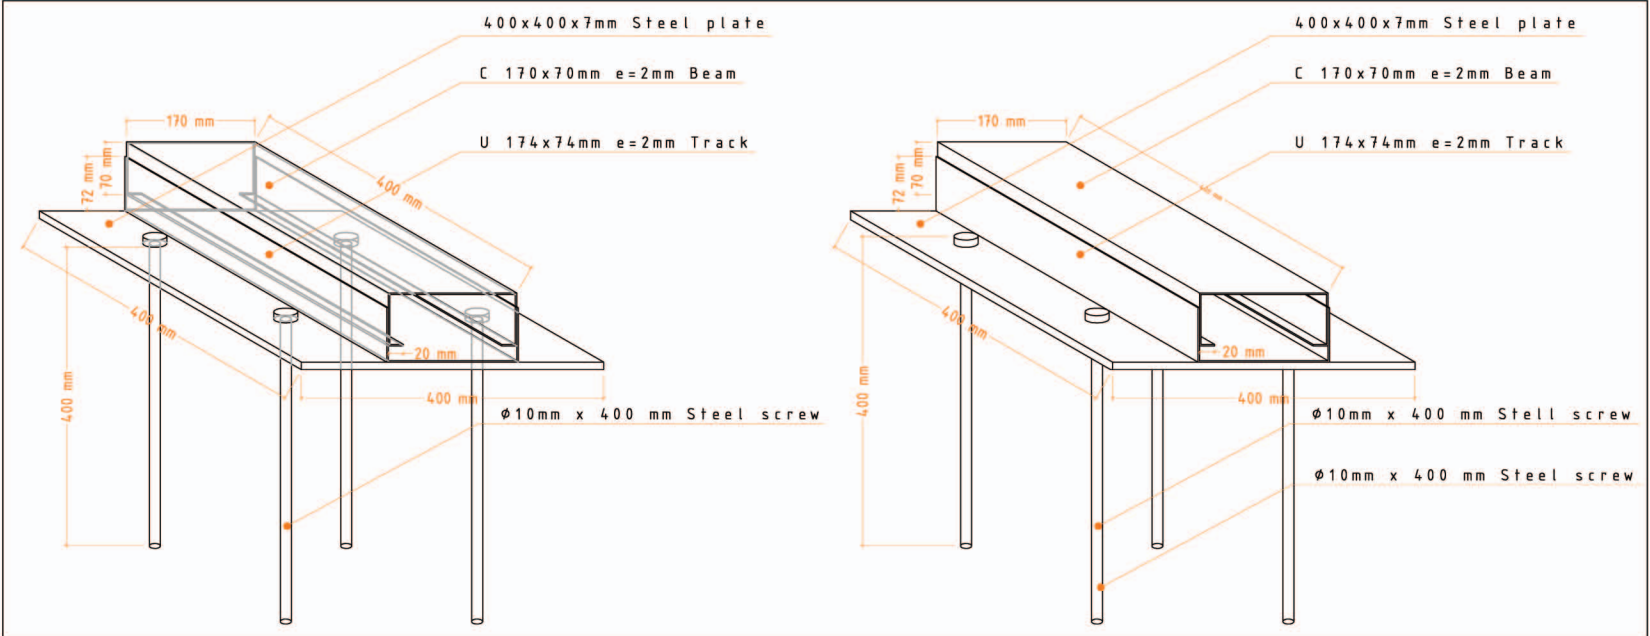

E: 1/10

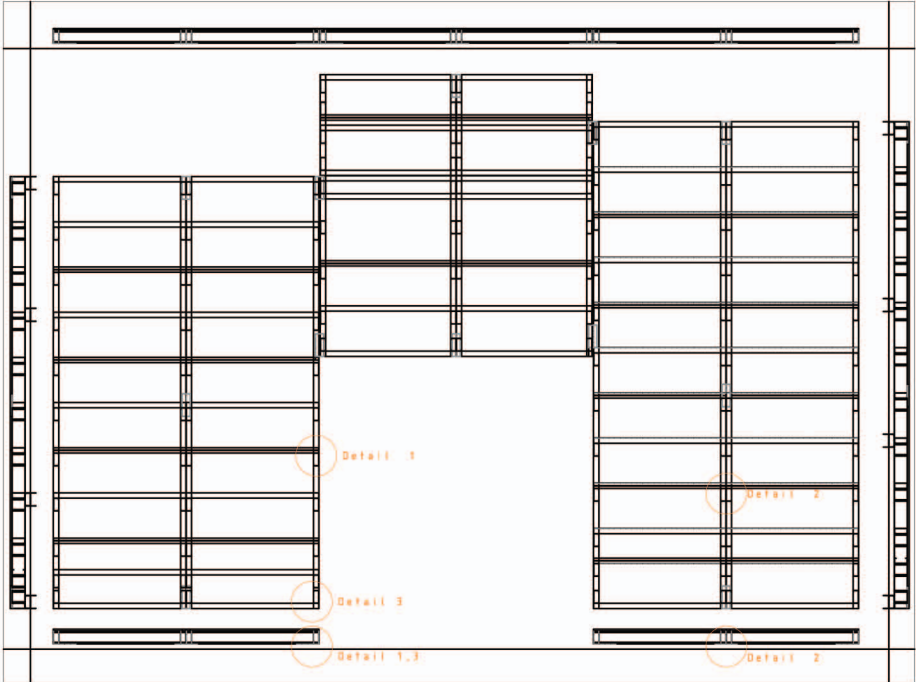

Ground floor plan.




Photograph: Ground floor structure during construction



S - 18

DATE: 2005.02.04

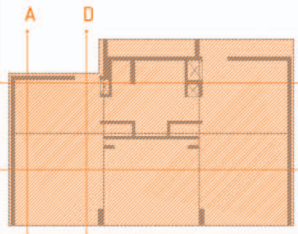

SCALE_1:30



JOAQUIN HIDALGO
plan designer
CARLOS BERMEJO
design coordinator
MIGUEL GOMEZ
general coordinator

JOE WORCESTER
professional engineer

ALFONSO GARCIA-SANTOS
construction manager
JAVIER NEILA
architecture manager
ESTEFANIA CAAMAÑO
general coordinator



unfolding under the sun
Universidad Politécnica de Madrid (UPM)

04/05

S - 18

1:30

GROUND FLOOR STRUCTURE