


Detail A



S - 21

DATE: 08.04.2005

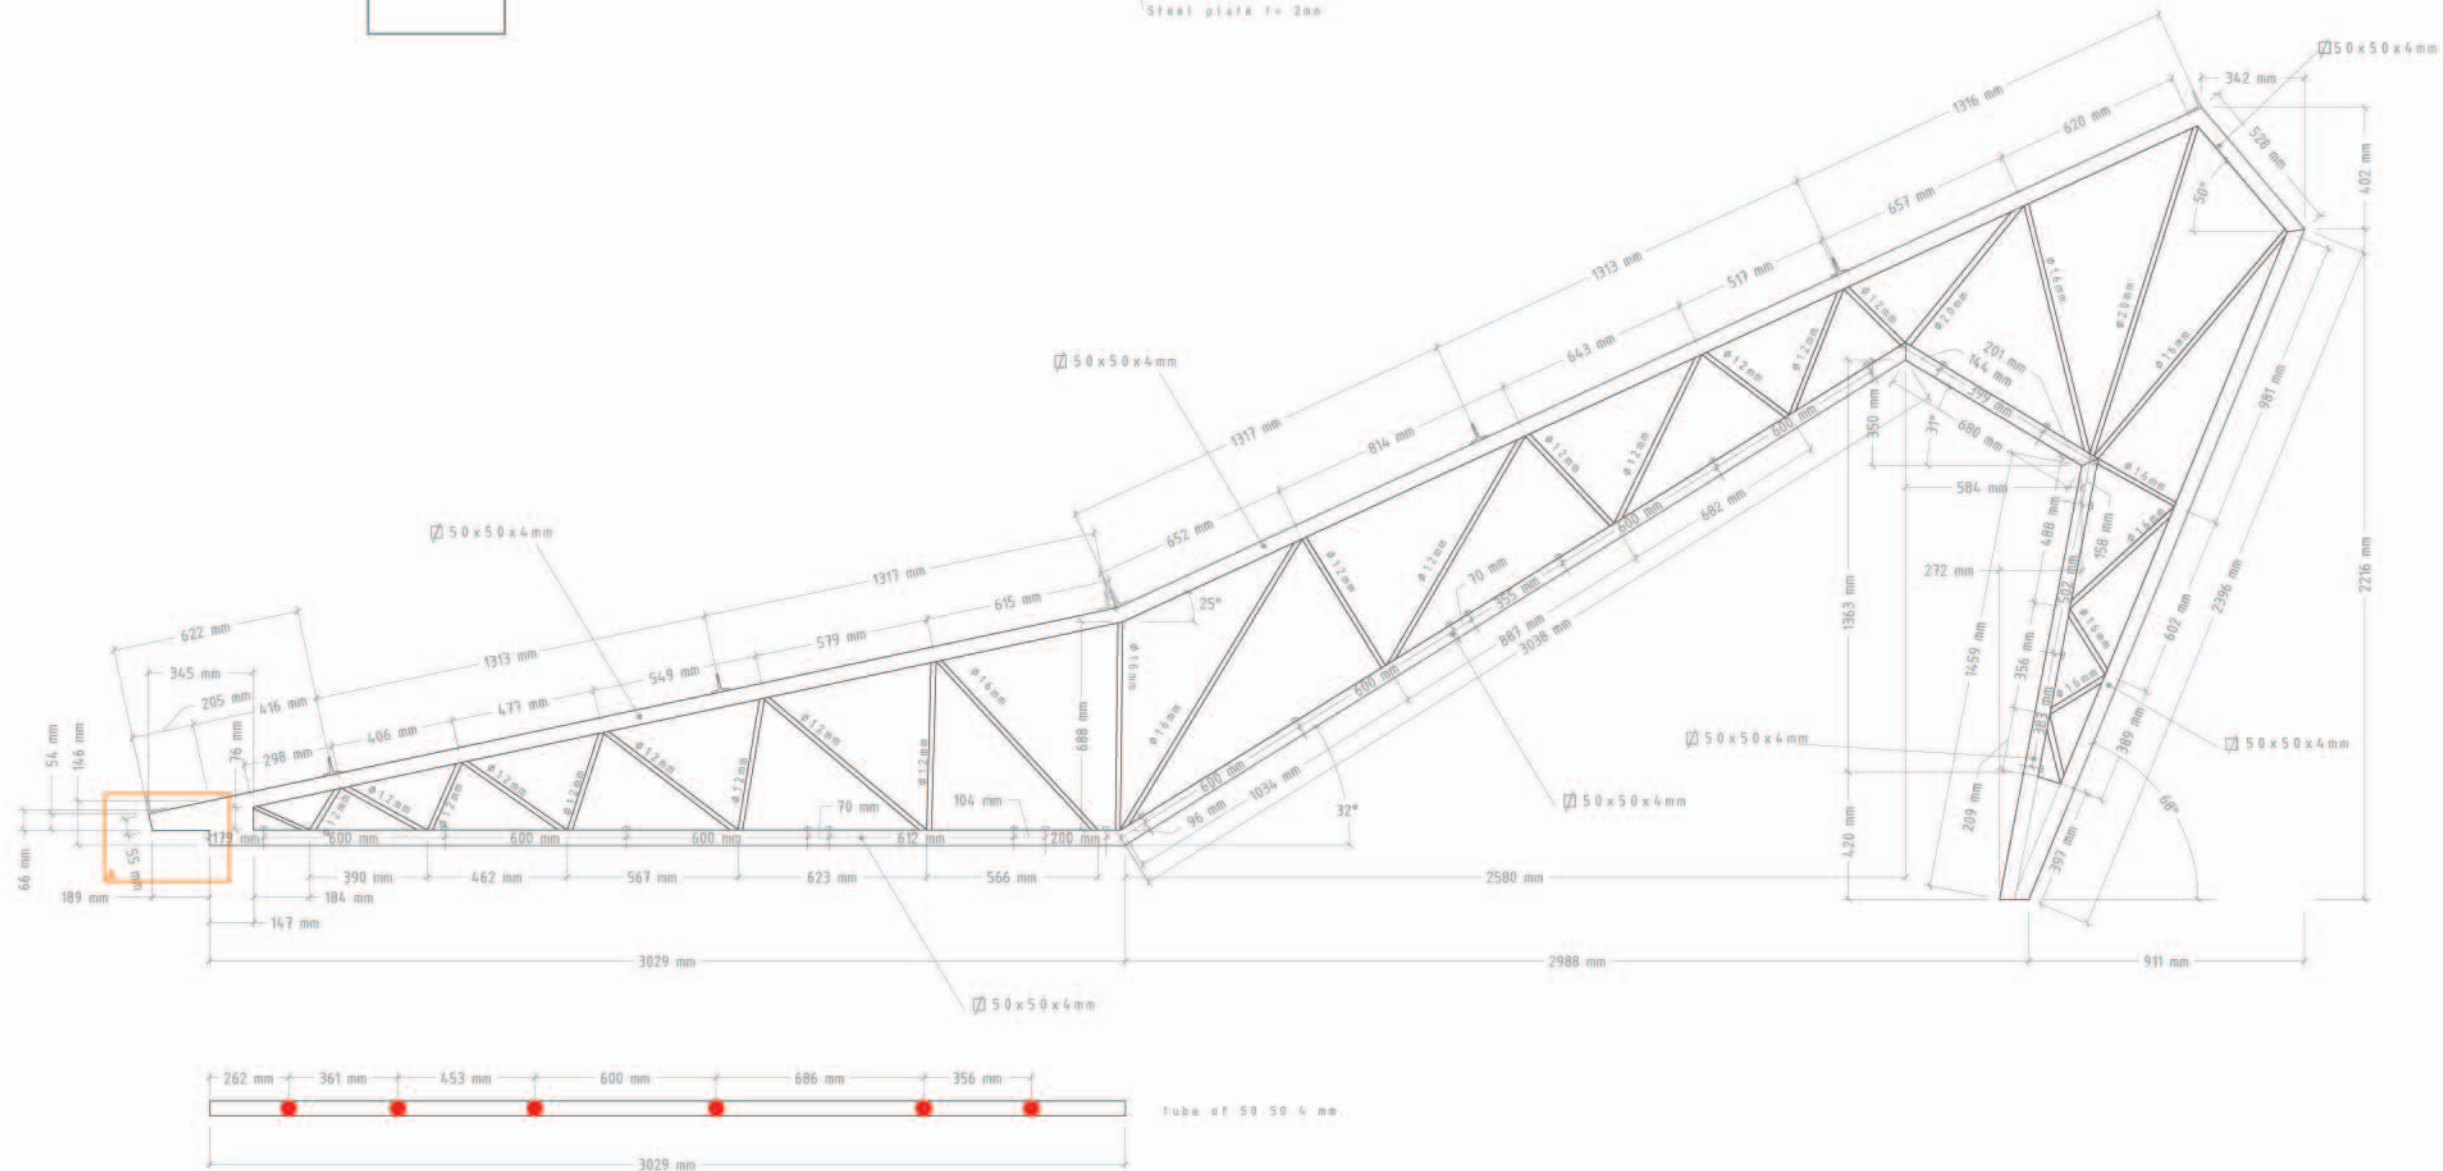

05/07

S - 21

SCALE_1:25



1:25

DESIGNERS

LUIS CLIMENT
plan designer

CARLOS BERMEJO
design coordinator

MIGUEL GOMEZ
general coordinator

COORDINATORS

JOE WORCESTER
professional engineer

ESTEFANIA CAAMAÑO
general coordinator

JAVIER NEILA
architecture manager

ALFONSO GARCIA-SANTOS
construction manager

ROOF FRAMING: TRUSS D

