
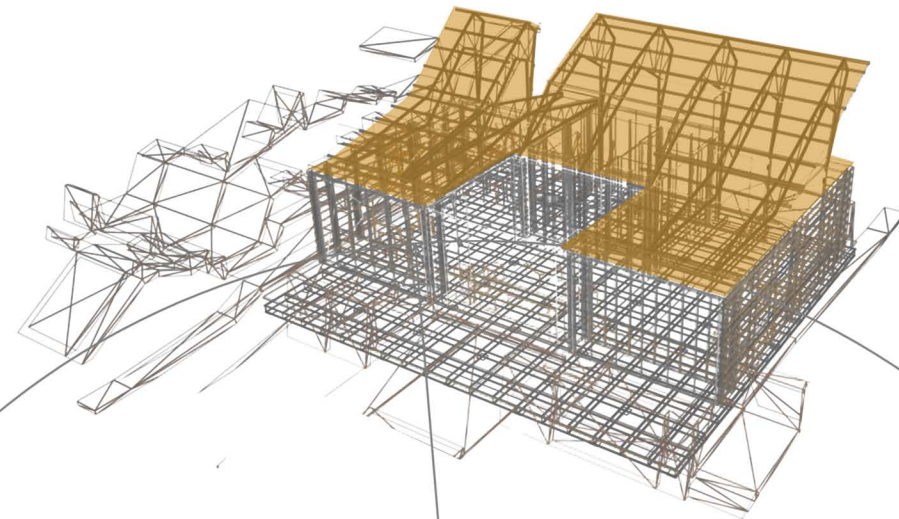


20 mt.

DAY 1


ELECTRIC GENERATORS
SITE LIGHTING SYSTEM
MOVABLE MODULE
GROUND FLOOR STRUCTURE
WALLS

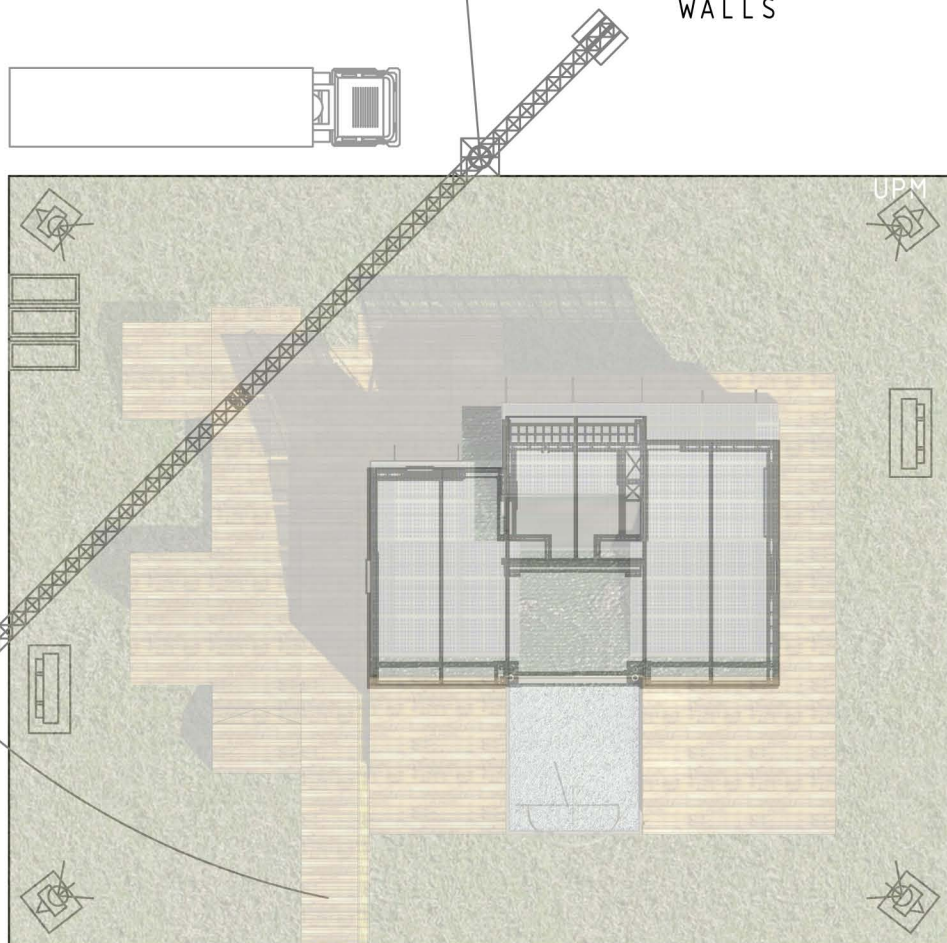

20 mt.

DAY 2

ROOF STRUCTURES

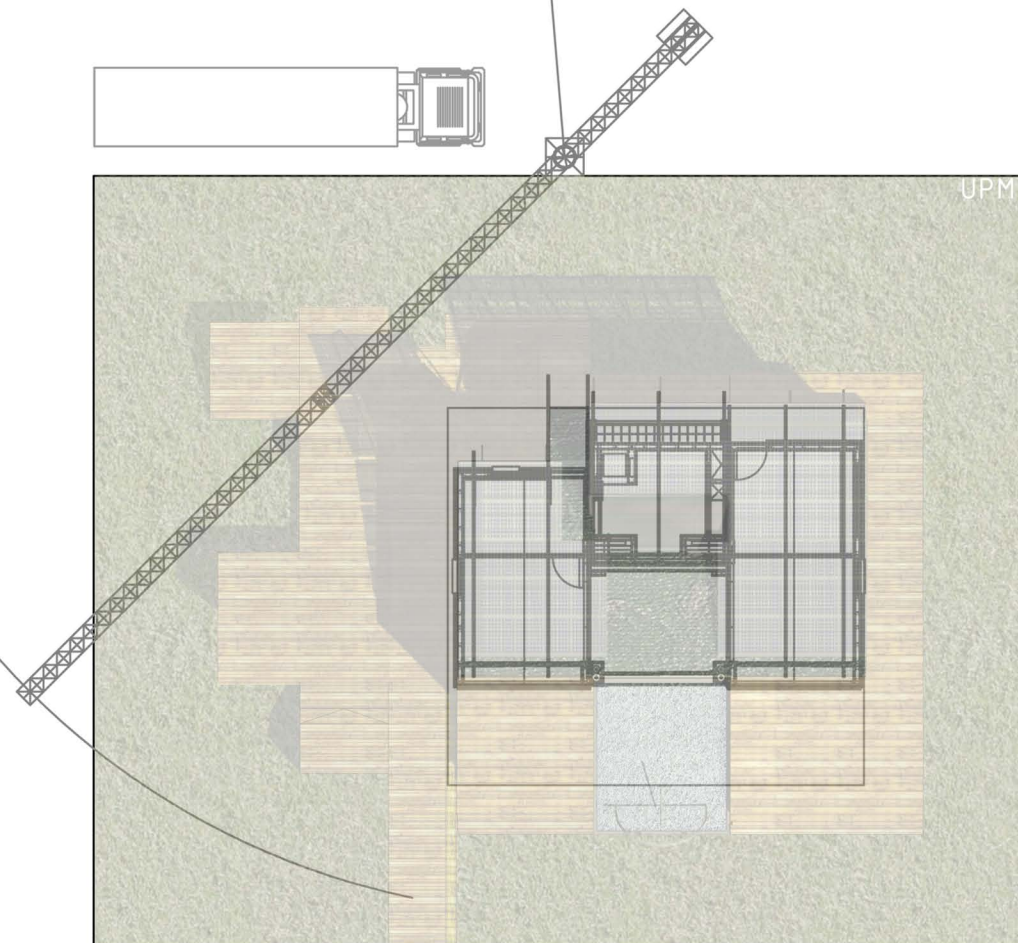

S0-62

DATE: 08.04.2005



01/03

S0-62

SCALE_1:200

0 1 2 3m

0 5 10ft

1:200

COORDINATORS SUPERVISORS DECATHLETES

IVÁN ALCANTARILLA
plan designer

CARLOS BERMEJO
design coordinator

MIGUEL GOMEZ
general coordinator

ALFONSO GARCIA-SANTOS
construction manager

JAVIER NEILA
architecture manager

ESTEFANIA CAAMAÑO
general coordinator

SITE OPERATIONS



unfolding under the sun
Universidad Politécnica de Madrid (UPM)