


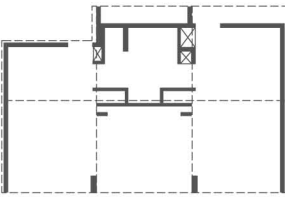
- SYMBOLS**
- RACEWAYS EXIT
 - ELECTRIC CONTROL BOX
 - RACEWAYS 30 cm
 - T-JOINT
 - JOINT 90°
 - CROSS JOINT
 - METAL FLOOR TILE FRAME
 - METAL FLOOR TILE PLOT
 - STRUCTURAL WALLS



SOLAR DECATHLON 2005 UPM Madrid

E - 5 2


DATE : 08.04.2005



01/01

E - 5 2

SCALE_1 : 4 0



0 0.5 1m
0 1 2 3ft

1 : 4 0


DECAT H L E T E S

SUSANA FERNANDEZ
plan designer

RAFAEL PALOMARES
graphic designer

MIGUEL GOMEZ
general coordinator

S U P E R V I S O R S

**idom**
ENGINEERING, ARCHITECTURE AND CONSULTING

CO O R D I N A T O R S


ANTONIO VILLANUEVA
IDOM industrial engineer

ALFONSO GARCIA-SANTOS
construction manager

JAVIER NEILA
architecture manager

ESTEFANIA CAAMAÑO
general coordinator

RACEWAYS



magic BOX
unfolding under the sun
Universidad Politécnica de Madrid (UPM)