







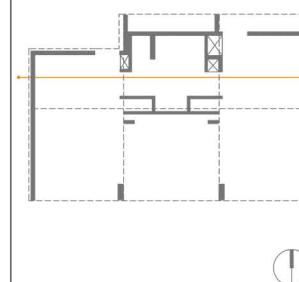
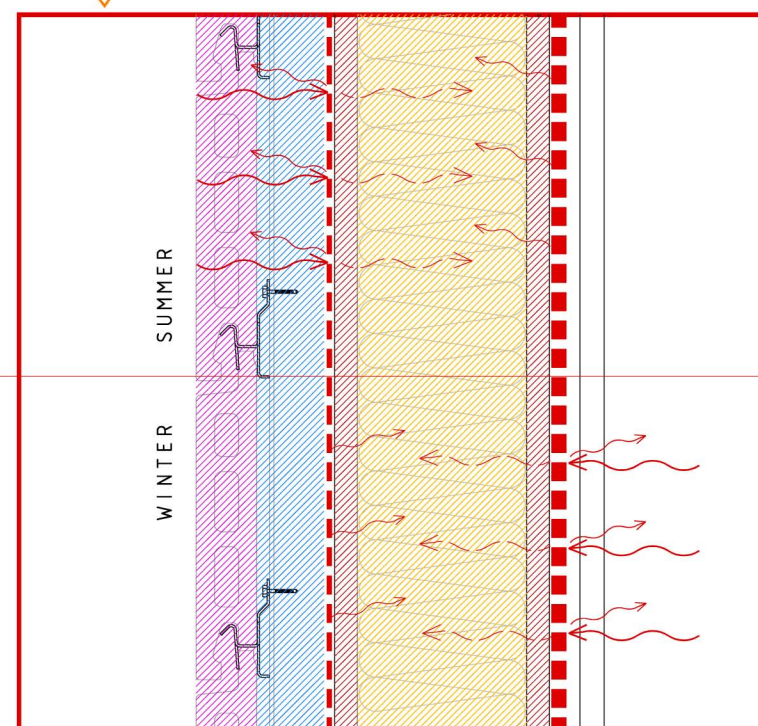
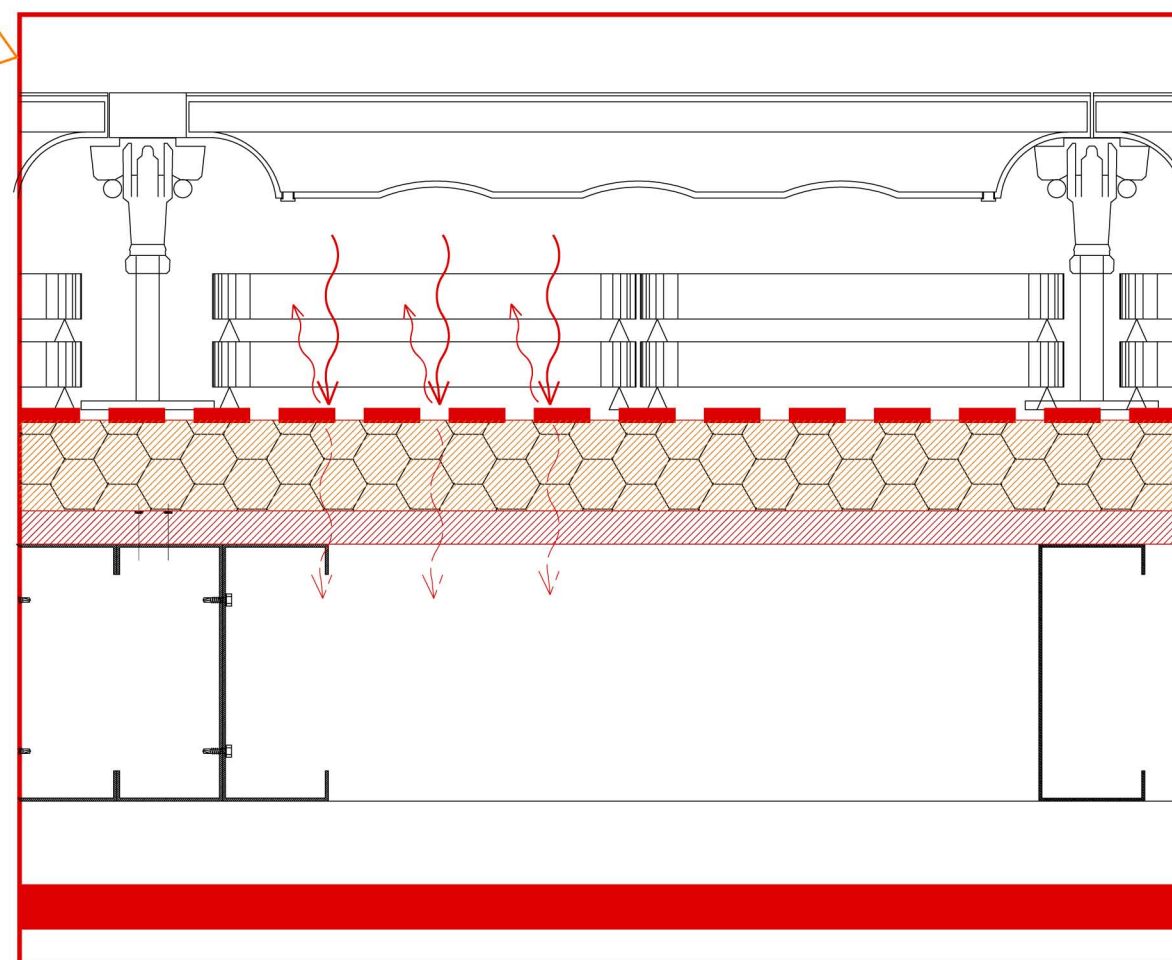
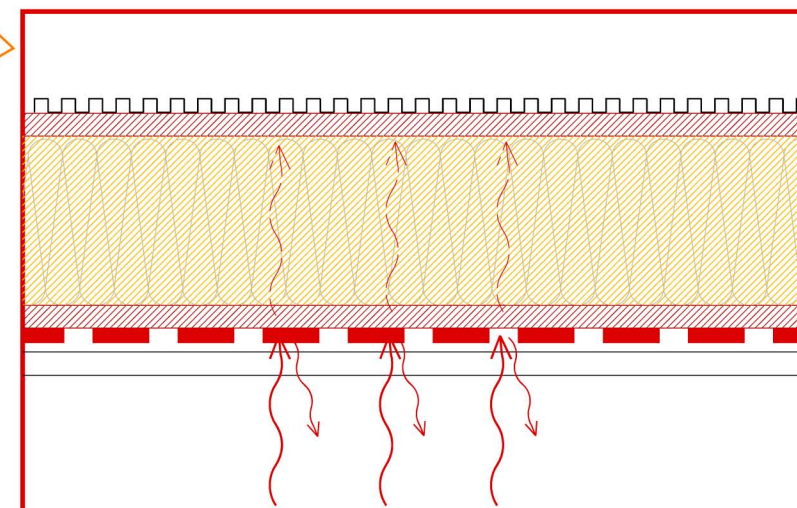


SECTION G

-  WATERPROOFING
-  BUBBLE WRAP ALUMINUM FOIL (LOW EMISSION AND REFLECTANT)
-  ALUMINUM FOIL (LOW EMISSION AND REFLECTANT)
-  ROCK WOOL
-  WOOD FIBRE
-  OSB
-  VENTILATED ZONE
-  EXTERIOR PROTECTION



SEVERAL SCALES

SCALE_1:10
SCALE_1:100

SEVERAL
SCALES

COORDINATORS SUPERVISORS DECATHLETES

CARLOS BERMEJO
plan designer

CARLOS BERMEJO
design coordinator

MIGUEL GOMEZ
general coordinator

ALFONSO GARCIA-SANTOS
construction manager

JAVIER NEILA
architecture manager

ESTEFANIA CAAMAÑO
general coordinator

INSULATION