


HANGING CUPBOARD

140x41x40 cm  
ALUMINUM STRUCTURE  
WHITE, GREEN, WENGE FINISH

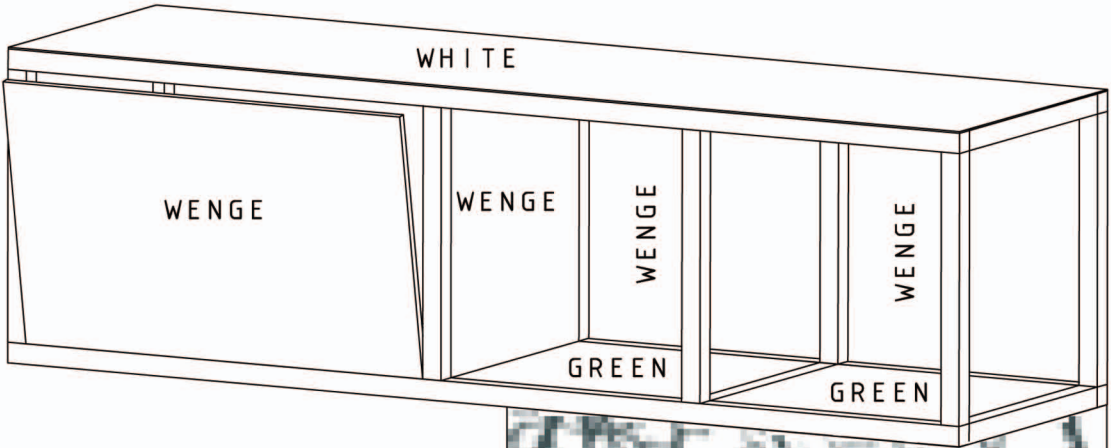

PULL-OUT TABLE

120(180)x90 cm h=72 cm  
ALUMINUM STRUCTURE

GREY-MINK

GREEN

GREY LEATHER

CHAIRS


40x40x92 cm h=47 cm  
ALUMINUM STRUCTURE

DINING ROOM FURNITURE




BC - 40

DATE: 08.04.2005

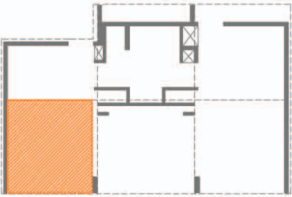

SCALE\_1:10

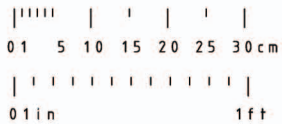

01/03

BC - 40

1:10

COORDINATORS SUPERVISORS DECATHLETES	MONICA ALMAGRO plan designer
	CARLOS BERMEJO design coordinator
	MIGUEL GOMEZ general coordinator
COORDINATORS SUPERVISORS DECATHLETES	ALFONSO GARCIA-SANTOS construction manager
	JAVIER NEILA architecture manager
	ESTEFANIA CAAMAÑO general coordinator

GENERAL FURNITURE



unfolding under the sun  
Universidad Politécnica de Madrid (UPM)