


A - 17

DATE: 08.04.2005

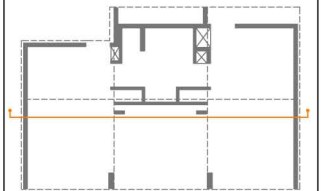

01/01

A - 17

SCALE\_1:40



1:40

MONICA ALMAGRO  
plan designer

CARLOS BERMEJO  
design coordinator

MIGUEL GOMEZ  
general coordinator

COORDINATORS SUPERVISORS DECATHLETES

ALFONSO GARCIA-SANTOS  
construction manager

JAVIER NEILA  
architecture manager

ESTEFANIA CAAMAÑO  
general coordinator

NORTH-FACING LONGITUDINAL SECTION



Universidad Politécnica de Madrid (UPM)