


- Z1. FIRE ALARM SYSTEM
- Z2. CEILING LIGHT
- Z3. SIGNAL
- Z4. POWER
- Z5. POWER
- Z6. SIGNAL
- Z7. PUSH. SOLAR GREENHOUSE
- Z8. C2
- Z9. TABLE LIGHTING

- Z10. NETWORK
- Z11. PUSH. TABLE LIGHTING
- Z12. PUSH. CEILING LIGHT
- Z13. PUSH. DORMA
- Z14. FRIDGE
- Z15. DISHWASHER
- Z17. KITCHEN'S SHELF LIGHTING
- Z16. C1

DININGROOM + KITCHEN

— WIRING INSTALLED BY THE ORGANIZATION

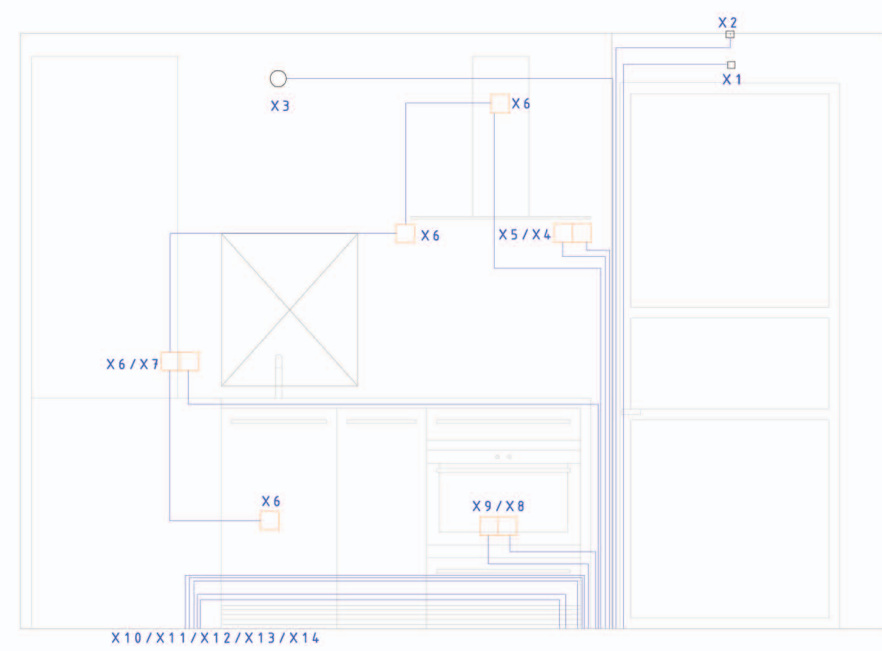

- X1. OUTDOOR LIGHTING
- X2. KITCHEN LIGHTING
- X3. HALL LIGHTING
- X4. PUSH. HALL AND FLUORESCENT LIGHTING
- X5. PUSH. FURNITURE LIGHTING
- X6. HOODS C1
- X7. NETWORK


KITCHEN

- X8. RANGE
- X9. OVEN
- X10. POWER
- X11. SIGNAL
- X12. MOTORS
- X13. MOTORS
- X14. SIGNAL (Z6)
- X15. POWER (Z5)



E - 5 2

DATE: 08.04.2005

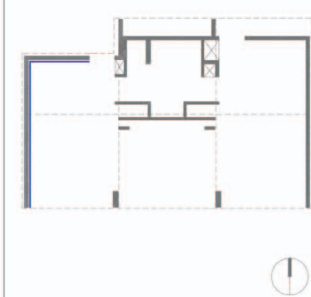

SCALE_1:30



SUSANA FERNANDEZ
plan designer

MONICA ALMAGRO
graphic designer

MIGUEL GOMEZ
general coordinator



ANTONIO VILLANUEVA
IDOM industrial engineer

ALFONSO GARCIA-SANTOS
construction manager

JAVIER NEILA
architecture manager

ESTEFANIA CAAMAÑO
general coordinator



unfolding under the sun
Universidad Politécnica de Madrid (UPM)



01/03

E - 5 2

1:30

WALL WIRING: WEST SIDE