




















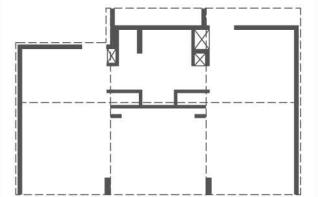
## SYMBOLS

-  SIMPLE POLE SWITCH (+0.95)
-  DOUBLE COMBINATION SWITCH (+0.95)
-  TRIPLE COMBINATION SWITCH (+0.95)
-  OUTLET 10/16A
-  OUTLET 15A (GFI)
-  OUTLET 20A (GFI)
-  RECESSED CEILING LUMINAIRE  
COMPACT DOWNLIGHT ERCO  
2xTC-DEL (10W)
-  DINING ROOM, KITCHEN AND OFFICE  
2xTC-DEL (13W)
-  RECESSED FLUORESCENTS  
· LIVING ROOM(COUCH)\_3x OSRAM LUMILUX  
T8 (18W) + SUPERMAX 2000 T4 (20W)
-  · KITCHEN\_RAIS LIGHTING T5 (35W)  
· KITCHEN FURNITURE\_2x RAIS LIGHTING  
T5 (8W)
-  · STUDIO SHELVES\_T8 (30W)  
· DINING ROOM\_ARKOS PROFILE 040 T5  
(39W)
-  · BEDROOM\_RAIS LIGHTING T5 (21W)  
· BED HEADBOARD\_4x SUPERMAX 2000 T4  
(20W)
-  · BATHROOM\_RAIS LIGHTING T5 (28W)  
· BATHROOM MIRROR LIGHT\_4x SUPERMAX  
2000 T4 (20W)
-  FLOOR/READING LAMP  
TC-TSE (20W)
-  RECESSED DOOR LUMINAIRE 0,21m  
STARLIGHT:AQUA-STAR  
OSRAM DULUX-S (9W)
-  RECESSED GREENHOUSE LUMINAIRE  
ERCO FLOOR WASHLIGHT  
TC-SEL (9W)
-  PRIMARY GROUNDING ELECTRODE
-  SECONDARY GROUNDING ELECTRODE
-  ELECTRIC CONTROL PANEL




E - 52

DATE: 08.04.2005



SCALE\_1:40

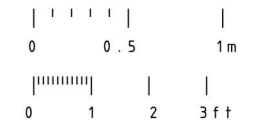

COORDINATORS SUPERVISORS DECATHLETES

SUSANA FERNANDEZ  
plan designer

MONICA ALMAGRO  
graphic designer

MIGUEL GOMEZ  
general coordinator



ANTONIO VILLANUEVA  
IDOM industrial engineer

ALFONSO GARCIA-SANTOS  
construction manager

JAVIER NEILA  
architecture manager

ESTEFANIA CAAMAÑO  
general coordinator



02/02

E - 52

1:40

ELECTRICAL SYSTEM