

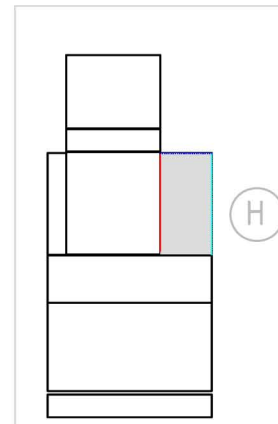
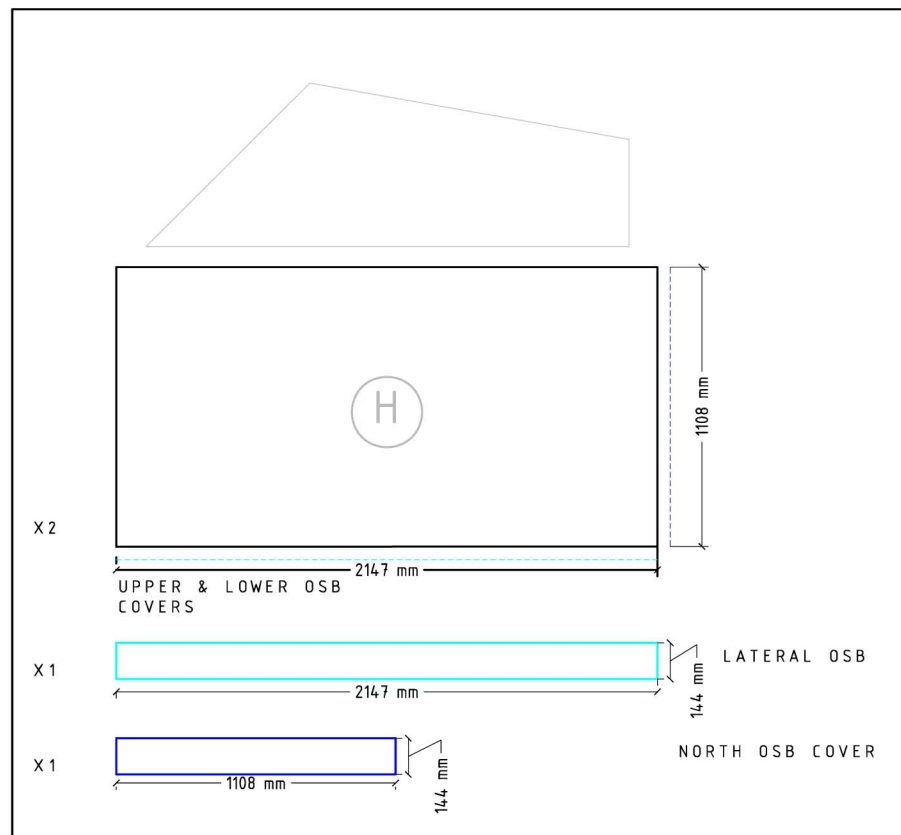


# AREA 1 OSB FLAT ROOF PANELS (KITCHEN & DINNING ROOM LAYOUT)



OSB ROOF PANELS (H)

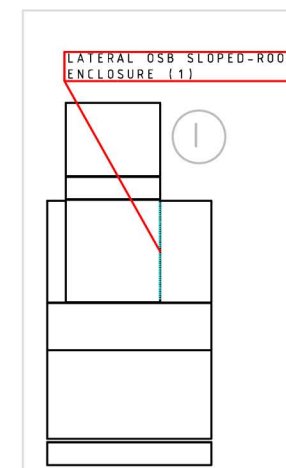



OSB LATERAL ENCLOSURE PANELS (I)

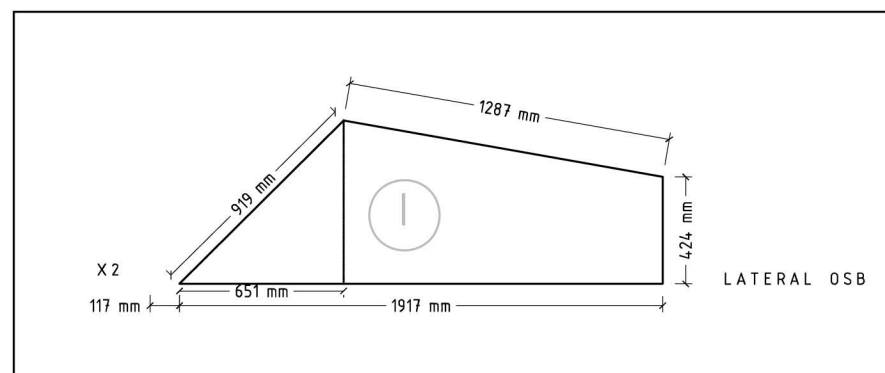

OSB ROOF PANELS (C)

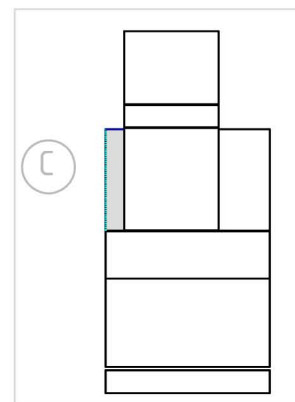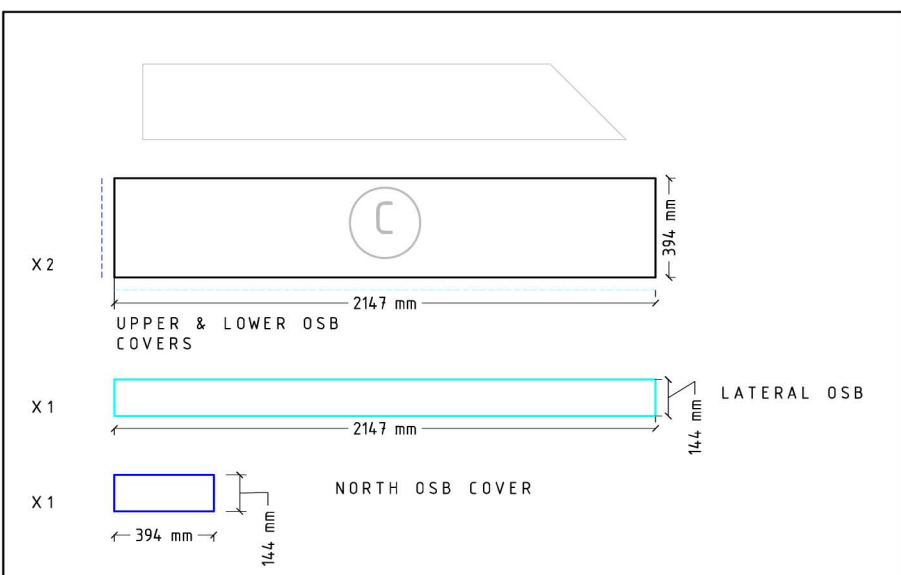


OSB LATERAL ENCLOSURE PANELS (D)

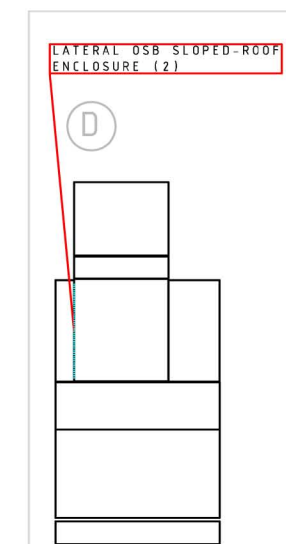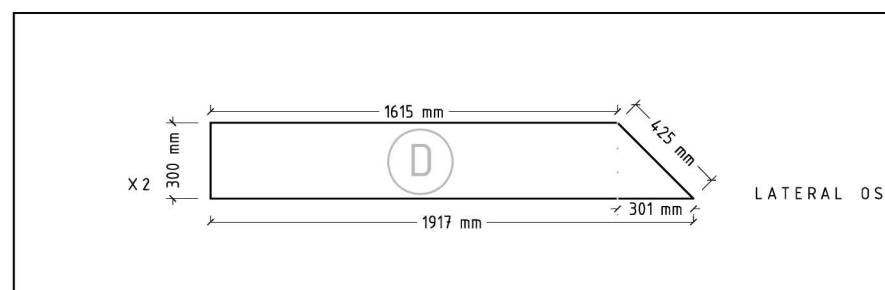


S - 22

DATE: 08.04.2005

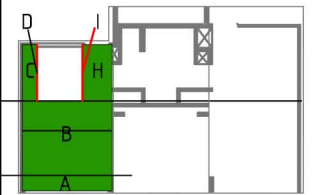

SCALE\_1:30

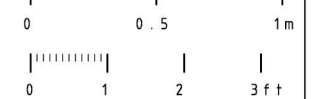

LETICIA RO-BER  
plan designer  
CARLOS BERMEJO  
design coordinator  
MIGUEL GOMEZ  
general coordinator

JOE WORCESTER  
professional engineer

ALFONSO GARCIA-SANTOS  
construction manager

JAVIER NEILA  
architecture manager

ESTEFANIA CAAMAÑO  
general coordinator



02/10

S - 22

1:30

OSB PANELS: ROOF LAYOUT