

Osb panels

Levels:

Wall top edge	+3.000m
Clay tiles top edge	+2.916m
Steel framing top edges	+2.731m
Suspended ceiling	+2.695m

Secondary framing

- 1 Extruded aluminum furring channel
- 2 Extruded aluminum corner key
- 3 Stainless steel clip

Floor	+0.465m
Steel framing bottom edge	+0.195m
Ground level	+0.000m +0.070m







Levels:

Wall top edge	+3.000m
Clay tiles top edge	+2.916m
Steel framing top edges	+2.731m
Suspended ceiling	+2.695m

Clay tiles


- 4 Clay tile
- 5 Stainless steel plate

Floor	+0.465m
Steel framing bottom edge	+0.195m
Ground level	+0.000m +0.070m

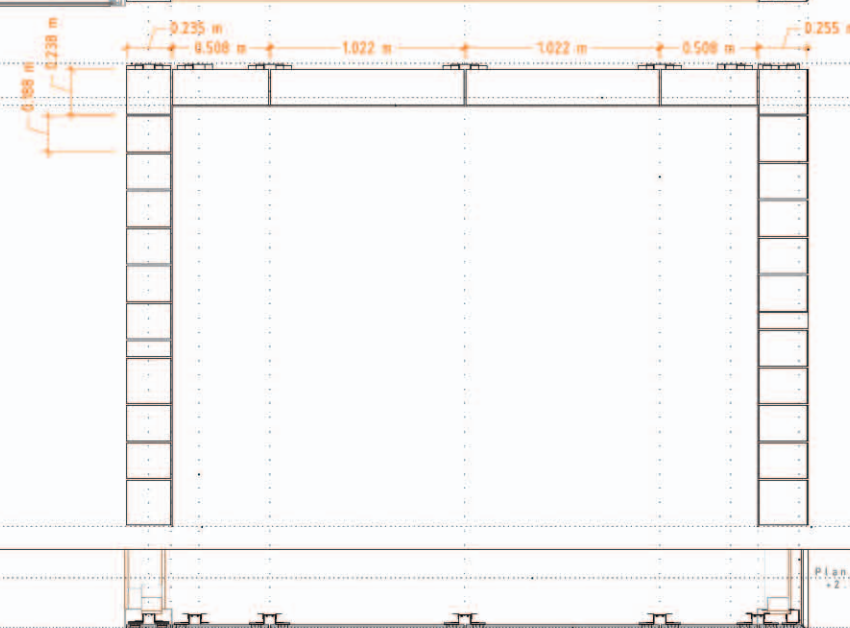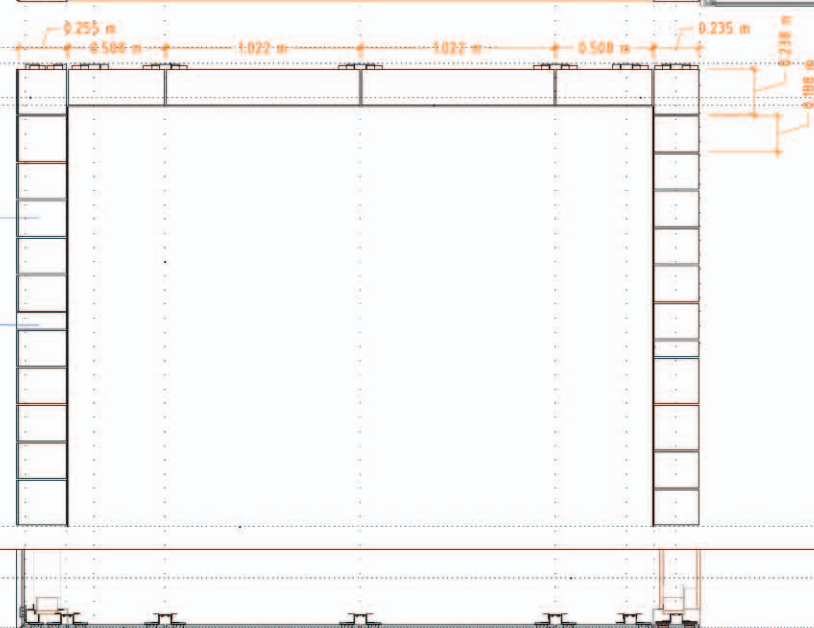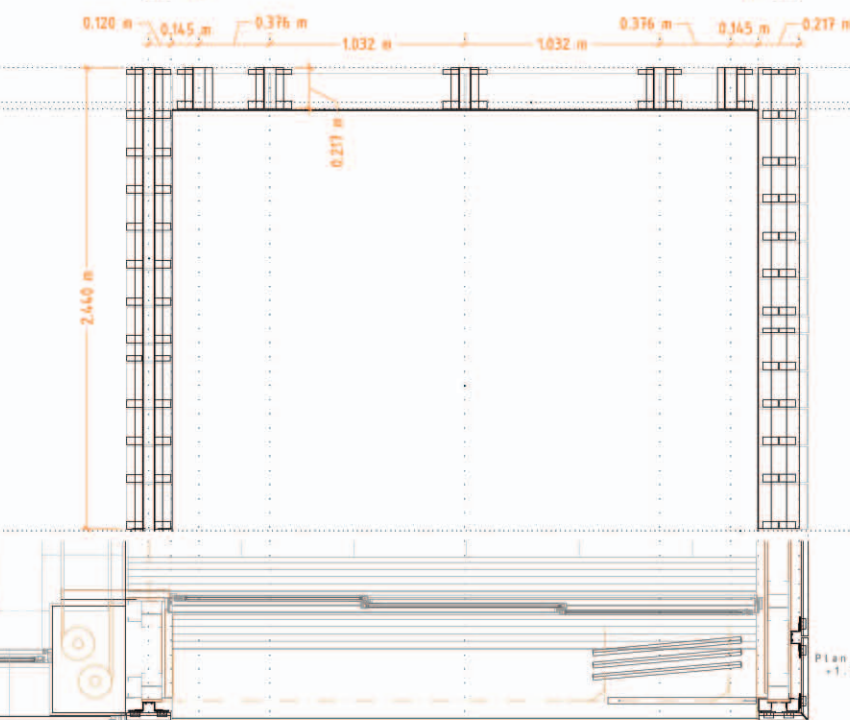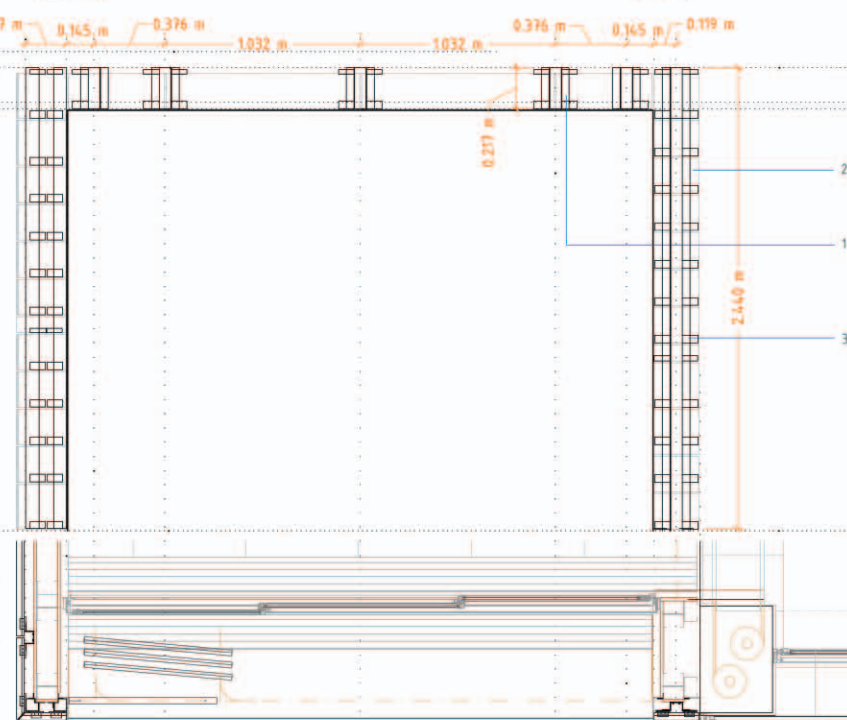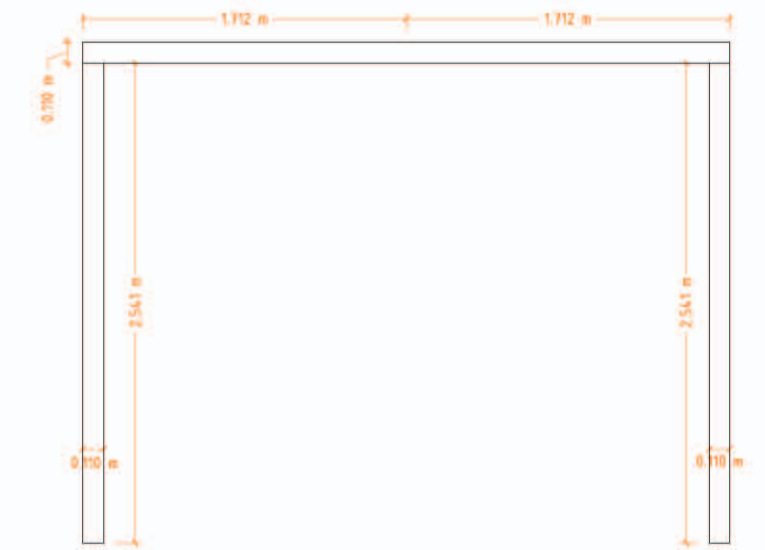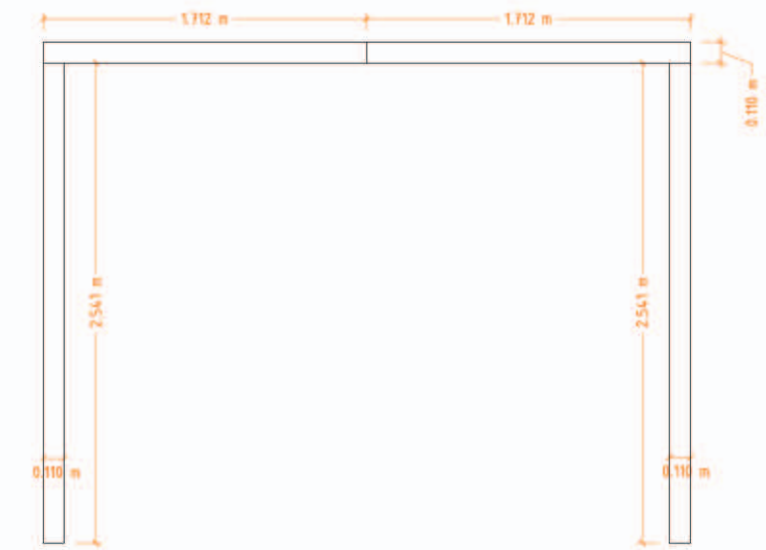

BC - 43

DATE: 08.04.2005

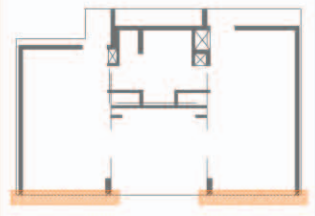

SCALE_1:40



COORDINATORS SUPERVISORS DECATHLETES

DANIEL CARDOSO
plan designer

CARLOS BERMEJO
design coordinator

MIGUEL GOMEZ
general coordinator

ALFONSO GARCIA-SANTOS
construction manager

JAVIER NEILA
architecture manager

ESTEFANIA CAAMAÑO
general coordinator



Intelling under the sun
Universidad Politécnica de Madrid (UPM)

01/04

BC - 43

1:40

EXT.FINISH:CLAY TILES - SOUTH