




SECTION E

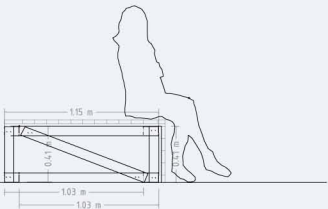

TOP E

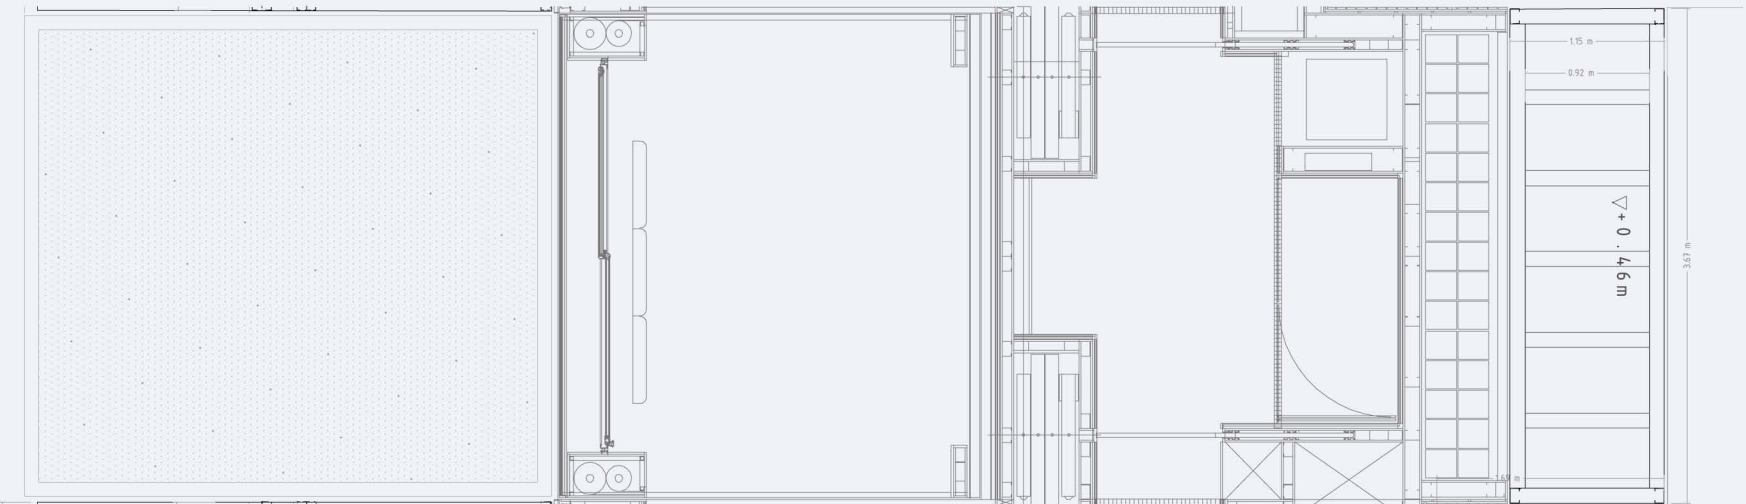

GENERAL PLAN

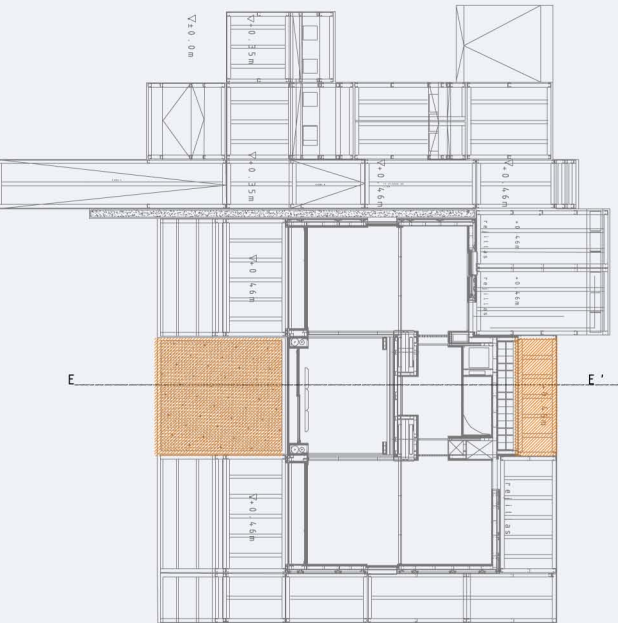

STRUCTURE \_\_\_\_\_ STEEL BUILT

WOODEN STRIPS


WOODEN  
SECONDARY STRUCTURE

CLIP

Ø 110


Ø 112

SCALE 1:5

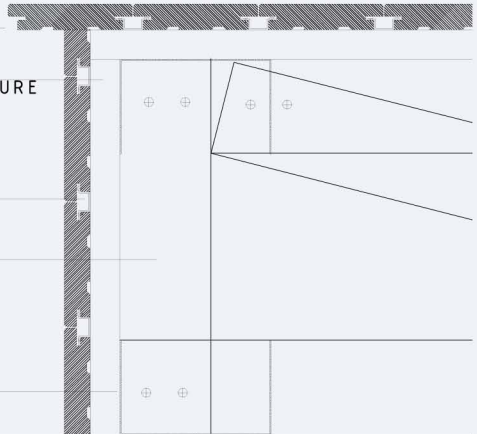

BC - 4 9

DATE: 08.04.2005

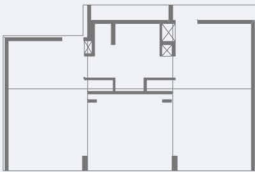

SEVERAL SCALES

SCALE\_ 1:50

SCALE\_ 1:5

MERCEDES PEÑA  
ISABEL MONTANÉS  
plan designer

CARLOS BERMEJO  
design coordinator

MIGUEL GOMEZ  
general coordinator

JOE WORCESTER  
professional engineer

ALFONSO GARCIA-SANTOS  
construction manager

JAVIER NEILA  
architecture manager

ESTEFANIA CAAMAÑO  
general coordinator



Universidad Politécnica de Madrid (UPM)

05/07

BC - 4 9

OUTDOOR AREAS