


BC - 27

DATE: 08.04.2005

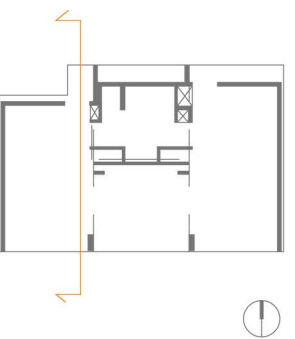

01/01

BC - 27

SCALE_1:40

0 0.5 1m

0 1 2 3ft

1:40

COORDINATOR SUPERVISOR DECATHLETES

CARLOTREZZO
plan designer

CARLOS BERMEJO
design coordinator

MIGUEL GOMEZ
general coordinator


JOE WORCESTER
professional engineer

ALFONSO GARCIA-SANTOS
construction manager

JAVIER NEILA
architecture manager

ESTEFANIA CAAMAÑO
general coordinator

SECTION B: MAIN ENTRANCE



unfolding under the sun

Universidad Politécnica de Madrid (UPM)