

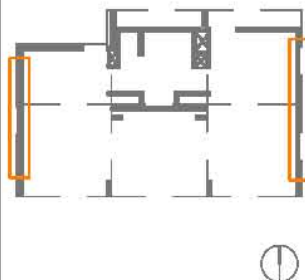



PICTURES

			
BC - 47		05/07	
DATE: 08.04.2005		BC - 47	
		SEVERAL SCALES	
SEVERAL SCALES		SEVERAL SCALES	
1 : 100		GLAZING AND FRAMING	
1 : 20			
1 : 5			
DECATHLETES		GLAZING AND FRAMING	
Jose Luis Perez-Griffa plan designer			
CARLOS BERMEJO design coordinator			
MIGUEL GOMEZ general coordinator		GLAZING AND FRAMING	
COORDINATORS			
SUPERVISORS			
ALFONSO GARCIA-SANTOS construction manager		GLAZING AND FRAMING	
JAVIER NEILA architectural manager			
ESTEFANIA CAAMAÑO general coordinator			
			
unfolding under the sun Universidad Politécnica de Madrid (UPM)			