




[1] NO DIVISION + PATIO

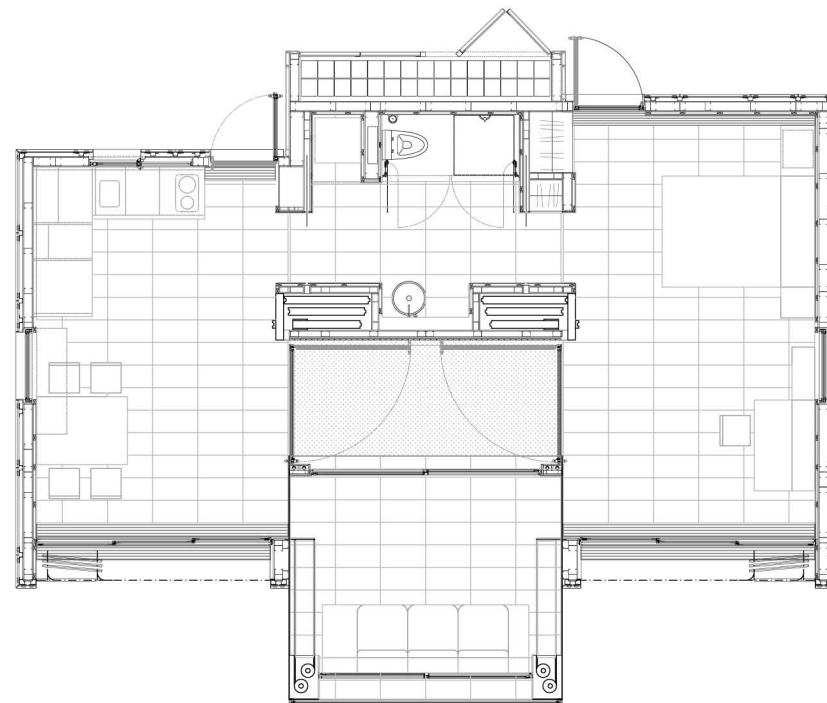

[2] NORTH-SOUTH DIVISION + PATIO

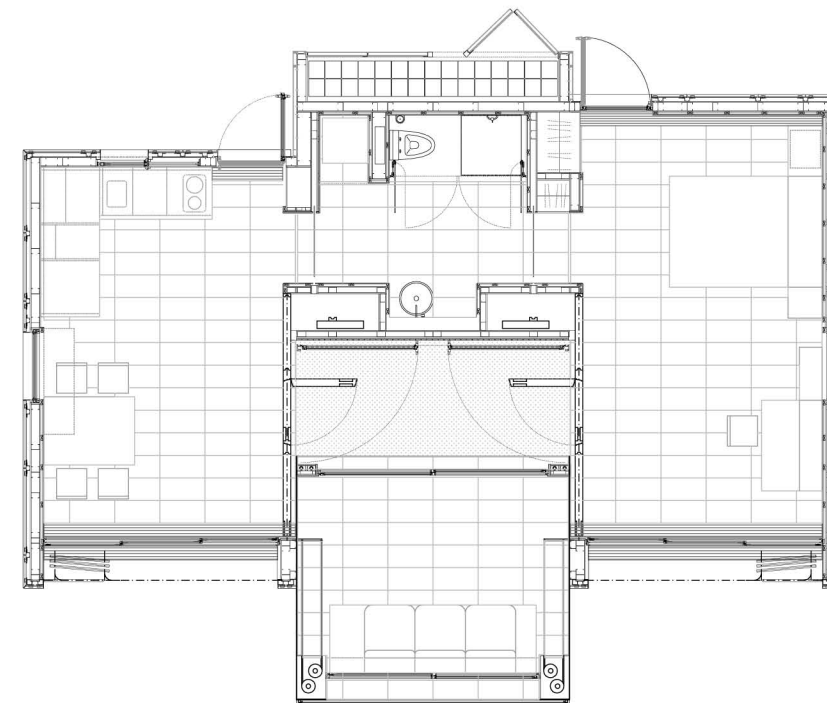

[3] CLOSED PATIO

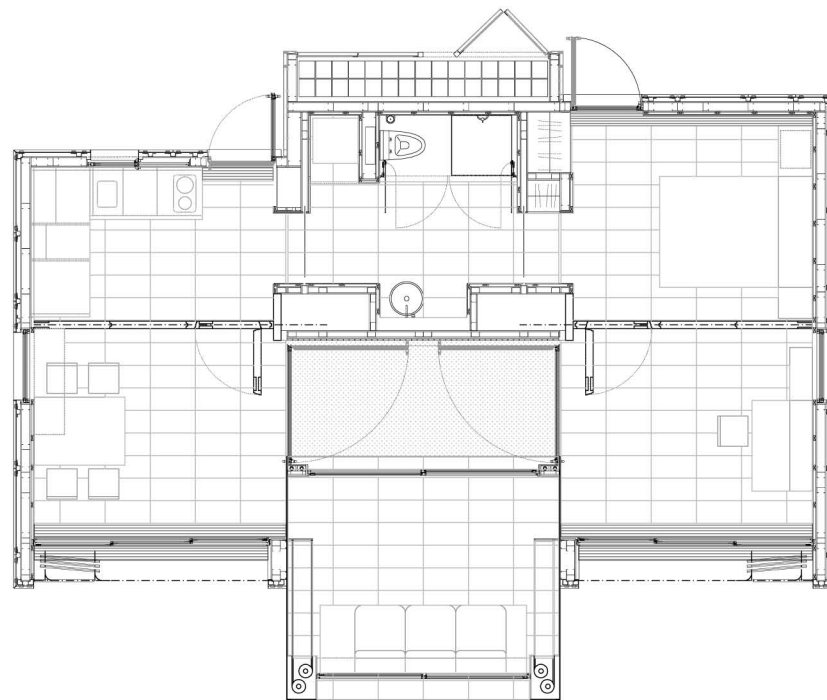

[1] NO DIVISION + PATIO

BEDROOM + OFFICE + LOUNGE + DINING ROOM + KITCHEN + BATHROOM + PATIO = 55.71m²

[2] NORTH-SOUTH DIVISION + PATIO

KITCHEN + BATHROOM + BEDROOM = 21.95m²

LOUNGE + DINING ROOM + OFFICE + PATIO = 33.76m²

[3] CLOSED PATIO


KITCHEN + DINING ROOM = 16.01m²

LOUNGE = 10.07m²

BEDROOM + OFFICE = 18.46m²

BATHROOM = 5.91m²

PATIO = 5.54 m²

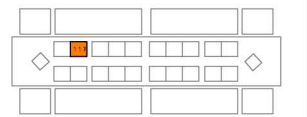

COORDINATORS	RAFAEL PALOMARES plan designer
	CARLOS BERMEJO design coordinator
	MIGUEL GOMEZ general coordinator
SUPERVISORS	
DECATHLETES	ALFONSO GARCIA-SANTOS construction manager
	JAVIER NEILA architecture manager
	ESTEFANIA CAAMAÑO general coordinator